

HAR. M 2042
12-1-62

WATER WELL DRILLERS LOG

Date: 12-1, 1962, Driller: C. I. SWITZER WELL CO. County: Harrison
(Name)

(1) Owner of Land: Jack Thomas
(Name)
225 Central Ave, Bayou
(Address)

(2) Location: 1/4, 1/4, Sec. T 19 R 9
_____ miles _____ of _____
(distance) (direction) (Nearest Town)

(3) Topography: (Hilly) (Flat) (Level)

(4) Purpose of Well: Domestic
(Domestic Irrigation
Municipal, Industrial, Other)

Description & Color of Materials Sand, Clay, Red Clay, Shell, etc.	Thick- ness Feet	Depth Feet
Clay	00	20
Sand	20	40
Clay	49	70
Sand	75	95
Clay	95	116
Sand	116	120
Sand, fine	148	140
Clay	140	250
Clay with sand sh	250	320
Clay	320	332
Sand good	332	340
Sand, belly	340	344

Information upon completion of well:

(1) Diameter 2 inches.

(2) Total Depth 348' feet.

(3) Water Level 4' feet below top of ground.


(4) Cased to 348', Size 2"

(5) Screen: Size 2", Length 10'

(6) Were any formations sealed against pollution?
 yes, _____ no.

If YES depth of formation _____
Why Health Dept. requirement

Drillers Remarks: _____

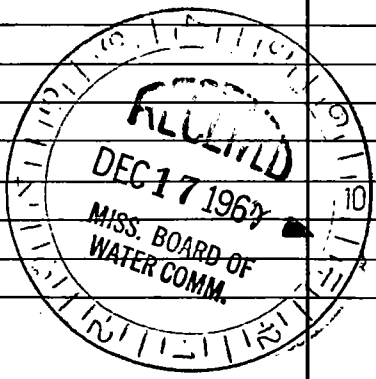

(Use Back Side)

Well No.

