

HAR.

MISSISSIPPI BOARD OF WATER COMMISSIONERS

M 2043

12-7-62

WATER WELL DRILLERS LOG

Date: 12-4, 1962, Driller: C. T. SWITZER WELL CO. County Harrison

(Name)

(1) Owner of Land: Willie Jackson (Name)

De Bump Rd. Hanksville (Address)

(2) Location: 1/4, 1/4, Sec. 7 10 T R, miles of (distance) (direction) (Nearest Town)

(3) Topography: (Hilly) (Flat) (Level)

(4) Purpose of Well: Domestic (Domestic Irrigation Municipal, Industrial, Other)

Description & Color of Materials Sand, Clay, Red Clay, Shell, etc.	Thick- ness Feet	Depth Feet
Sand	00	64
Clay	64	79
Sand	79	104
Clay	104	146
Clay w/ sand etc	146	166
Clay	166	226
Sand, fine	226	241
Clay	241	306
Sand, fine	306	326
Clay	326	363
Sand	363	371
Clay	371	478
Sand	478	489
Sand, fine	489	509
Sand	509	514
Clay	514	586
Sand, fine	586	631

Information upon completion of well:

(1) Diameter 2 inches.

(2) Total Depth 631 feet.

(3) Water Level 13' feet below top of ground.

(4) Cased to 631', Size 2"


(5) Screen: Size 2", Length 10'

(6) Were any formations sealed against pollution? yes, no.

If YES depth of formation

Why North Dept. Requirements

Drillers Remarks:

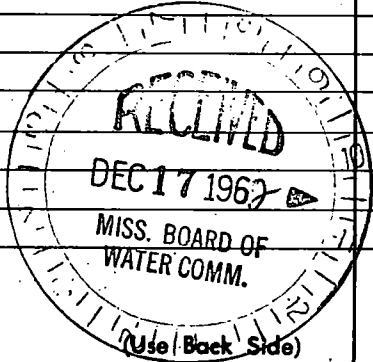

Well No.

