

HAR.

MISSISSIPPI BOARD OF WATER COMMISSIONERS

AN
1-2-63

2045

WATER WELL DRILLERS LOG

Date: 1-1, 1963, Driller: C. F. Switzer County Harrison
(Name)

(1) Owner of Land: Joseph Wolfe
(Name)

St. I. Bourne Rd., Gulfport
(Address)

(2) Location: 1/4, 1/4, Sec. T 7 R 10
miles of
(distance) (direction) (Nearest Town)

(3) Topography: Flat
(Hilly) (Flat) (Level)

(4) Purpose of Well: Domestic
(Domestic Irrigation
Municipal, Industrial, Other)

Description & Color of Materials Sand, Clay, Red Clay, Shell, etc.	Thick- ness Feet	Depth Feet
Clay	00	00
Sand	20	60
Sand & Gravel	60	87
Clay	90	100
Clay & Sand like	100	140
Clay	140	155
Sand	155	190

Information upon completion of well:

(1) Diameter 2 inches.

(2) Total Depth 190 feet.

(3) Water Level 11' feet below top of ground.

(4) Cased to 190', Size 2"


(5) Screen: Size 2", Length 10'

(6) Were any formations sealed against pollution?
✓ yes, no.

If YES depth of formation _____

Why Health Dept. Requirement

Drillers Remarks: _____

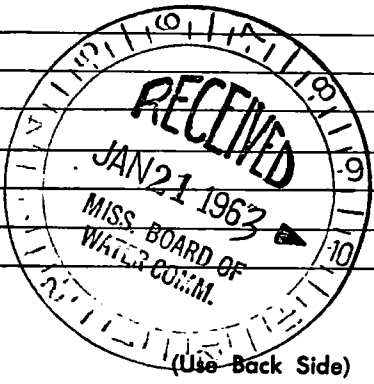

Well No.

