

HAR.

MISSISSIPPI BOARD OF WATER COMMISSIONERS

M 2051  
4-24-63

WATER WELL DRILLERS LOG

Date: Apr. 24, 1963 Driller: L. L. Garland County: Jackson  
(Name)

(1) Owner of Land	Description & Color of Materials Sand, Clay, Red Clay, Shell, etc.	Thick- ness Feet	Depth Feet
<u>Wallace Fayard</u> (Name)	1 Clay		
<u>Lay Road</u> (Address)	2 Mud, s.s. & gravel		
(2) Location: <u>1/4</u> , <u>1/4</u> , Sec. <u>73 R 94</u>	3 14' s.s. 7' mud		
<u>4</u> miles <u>NW</u> <u>Adberville</u> (distance) (direction) (Nearest Town)	4 10' s.s. 11' mud		
(3) Topography: <u>Dom.</u> (Hilly) (Flat) (Level)	5 mud		
(4) Purpose of Well: <u>Dom.</u> (Domestic Irrigation Municipal, Industrial, Other)	6 "		
	7 " & s.s.		
	8 "		
	9 mix		
	10 mud		
	11 "		
	12 " & s.s.		
	13 " shale		
	14 14' mix. 7' sand		
	15 mud		
	16 16' mud 5' sand		
	17 9' sand		

Information upon completion of well:

(1) Diameter 2 inches.

(2) Total Depth 345 feet.

(3) Water Level 16 feet below top of ground.

(4) Cased to \_\_\_\_\_, Size \_\_\_\_\_.


(5) Screen: Size .08, Length 10.

(6) Were any formations sealed against pollution?  
\_\_\_\_\_ yes, \_\_\_\_\_ no.

If YES depth of formation \_\_\_\_\_

Why \_\_\_\_\_

Drillers Remarks: \_\_\_\_\_

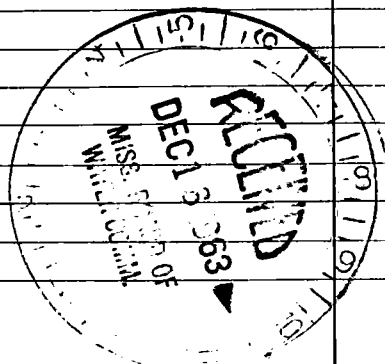

(Use Back Side)

Well No.

