

HAR.

MISSISSIPPI BOARD OF WATER COMMISSIONERS

25

M 2054

7-8-63

WATER WELL DRILLERS LOG

Date: July 8 1963, Driller: L. L. Garland, County: Jackson

(Name)

(1) Owner of Land: Mr. M. Ewen

(Name)

Description & Color of Materials
Sand, Clay, Red Clay, Shell, etc.

Thick-
ness
Feet

Depth
Feet

(Address)

(2) Location: 1/4, 1/4, Sec. T. 1, R. 10

3 miles NW Oberville, of (Nearest Town)

(3) Topography: (Hilly) (Flat) (Level)

(4) Purpose of Well: Dom. (Domestic Irrigation, Municipal, Industrial, Other)

1	Mix.		
2	Mud & s.s.		
3	Sand		
4	Mud		
5	Mix.		
6	12' s. 9' M.		
7	Mud		
8	" s.s.		
9	Mix.		
10	Mud		
11	8' s. 13' M.		
12	Mud		
13	" & Shale		
14	3" s. 12" M. 6' M.		
15	Mix.		
16	Mix.		
17	"		
18	Sand		
19	Mix.		
20	18' Sand		

Information upon completion of well:

(1) Diameter 2 inches.

(2) Total Depth 417 feet.

(3) Water Level 34 feet below top of ground.

(4) Cased to _____, Size _____

(5) Screen: Size .08, Length 16


(6) Were any formations sealed against pollution?

yes, no.

If YES depth of formation _____

Why _____

Drillers Remarks: _____

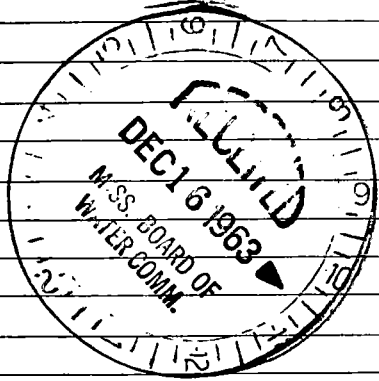

(Use Back Side)

Well No.

