

HAR.

MISSISSIPPI BOARD OF WATER COMMISSIONERS

M

2056

7-15-63

WATER WELL DRILLERS LOG

C. T. SWITZER WELL CO.

Date: 7-15, 1963, Driller: \_\_\_\_\_ County Harrison

(Name)


(1) Owner of Land: Hunters Restaurant  
 (Name)  
Corner Hwy 90 & Port Harrison  
 (Address)  
 (2) Location: \_\_\_\_\_ 1/4, \_\_\_\_\_ 1/4, Sec. 7-10 T R  
 \_\_\_\_\_ miles \_\_\_\_\_ of \_\_\_\_\_  
 (distance) (direction) (Nearest Town)  
 (3) Topography:  (Hilly)  (Flat)  (Level)  
 (4) Purpose of Well: Commercial  
 (Domestic Irrigation, Municipal, Industrial, Other)

Description & Color of Materials Sand, Clay, Red Clay, Shell, etc.	Thick- ness Feet	Depth Feet
sand	30	34
clay	34	112
sand	112	135
clay	135	149
sand & sbs	149	170
clay w/ sand & sbs	170	192
sand & sbs	192	215
sand	215	237
clay	237	257
sand & sbs	257	279
clay	279	322
sand	322	332
clay	332	496
clay sand & sbs	496	519
clay	519	648
sand	648	690

Information upon completion of well:

(1) Diameter 4x3" inches.  
 (2) Total Depth 690' feet.  
 (3) Water Level 14 1/2' feet below top of ground.  
 (4) Cased to 690', Size 3"x4"  
 (5) Screen: Size 3", Length 40'  
 (6) Were any formations sealed against pollution?  
 yes, \_\_\_\_\_ no.

If YES depth of formation \_\_\_\_\_  
 Why Health Dept requirements  
 Drillers Remarks: \_\_\_\_\_

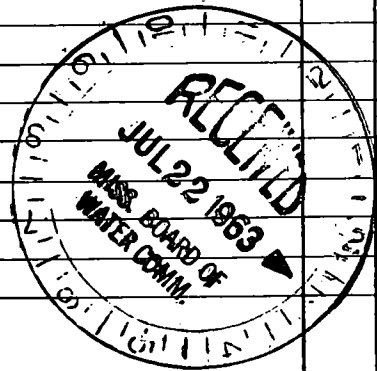

(Use Back Side)

Well No.

