

HAR.

MISSISSIPPI BOARD OF WATER COMMISSIONERS

M 2056
7-25-63

WATER WELL DRILLERS LOG

Date: 7/25, 1963, Driller: C. T. SWITZER WELL CO. County: Harrison

(Name)

(1) Owner of Land: A. L. Hutton
(Name)
Old Hwy 90, Bogalusa
(Address)

(2) Location: 7 10 T R
1 miles of
(distance) (direction) (Nearest Town)

(3) Topography: (Hilly) (Flat) (Level)

(4) Purpose of Well: Domestic
(Domestic Irrigation, Municipal, Industrial, Other)

Description & Color of Materials Sand, Clay, Red Clay, Shell, etc.	Thick- ness Feet	Depth Feet
Clay	10	10
Sand	10	30
Clay	30	100
Sand, fine	100	140
Clay	140	240
Sand, fine	240	280
Clay	280	400
Sand, red gravel	400	451

Information upon completion of well:

(1) Diameter 2" inches.

(2) Total Depth 451' feet.

(3) Water Level 2' feet below top of ground.


(4) Cased to 451', Size 2"

(5) Screen: Size 2", Length 10'

(6) Were any formations sealed against pollution?
 yes, no.

If YES depth of formation
Why Health Dept. requirement

Drillers Remarks:

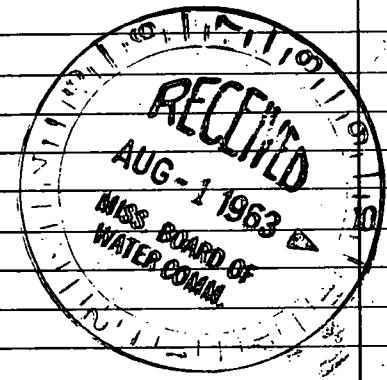

(Use Back Side)

Well No.


71-00
200-11
200-20
200-101
200-115
200-110
200-112
200-113

Handwritten notes and scribbles, including the word "control" and other illegible markings.

Handwritten notes and scribbles, including the word "control" and other illegible markings.

Vertical text and markings, possibly a list or index, including the number "3" and "4".

Handwritten notes and scribbles, including the word "control" and other illegible markings.

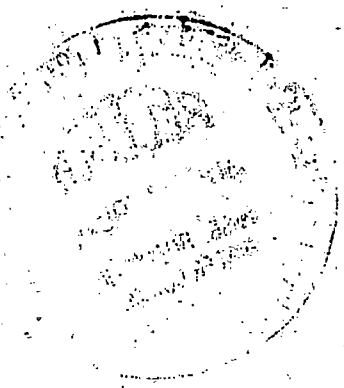

Handwritten notes and scribbles at the bottom right of the page, including the word "control" and other illegible markings.