

M 2009  
7-30-63

WATER WELL DRILLERS LOG

Date: 7/30, 1963, Driller: C. T. SWITZER WELL CO. County: Norfolk  
(Name)

(1) Owner of Land: Justin Parker  
(Name)  
229 St. Martin Rd, Bogalusa  
(Address)

(2) Location: 1/4, 1/4, Sec. 79 T R  
\_\_\_\_\_ miles \_\_\_\_\_ of \_\_\_\_\_  
(distance) (direction) (Nearest Town)

(3) Topography: ✓  
(Hilly) (Flat) (Level)

(4) Purpose of Well: Domestic  
(Domestic Irrigation  
Municipal, Industrial, Other)

Description & Color of Materials Sand, Clay, Red Clay, Shell, etc.	Thick- ness Feet	Depth Feet
Clay	20	20
Sand	20	40
Clay	40	60
Sand, good	60	100
Clay	100	120
Sand, good	120	136
Clay	136	220
Clay & sand str.	220	240
Sand, good	240	290

Information upon completion of well:

(1) Diameter 2 inches.

(2) Total Depth 290 feet.

(3) Water Level 9' feet below top of ground.


(4) Cased to 290', Size 2"

(5) Screen: Size 2", Length 10'

(6) Were any formations sealed against pollution?  
✓ yes, \_\_\_\_\_ no.

VOCATE

If YES depth of formation \_\_\_\_\_  
Why: Health Dept. requirement  
Drillers Remarks: \_\_\_\_\_

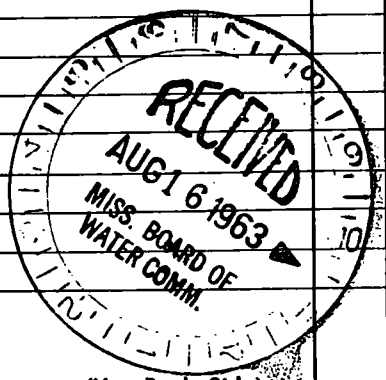

Well No.

(Use Back Side)

