

HAR.
M

MISSISSIPPI BOARD OF WATER COMMISSIONERS

7-30-63

WATER WELL DRILLERS LOG

Date: July 30, 1963, Driller: L. S. Garland Jackson County

(Name)

(1) Owner of Land: Walter Topazynski
 (Name)
North Biloxi
 (Address)

(2) Location: 1/4, 1/4, Sec. 19 T 1 R 9
 (distance) (direction) (Nearest Town)

(3) Topography: _____
 (Hilly) (Flat) (Level)

(4) Purpose of Well: Dom.
 (Domestic Irrigation
 Municipal, Industrial, Other)

Description & Color of Materials (Sand, Clay, Red Clay, Shell, etc.)	Thick- ness Feet	Depth Feet
1 Clay		
2 mix		
3 "		
4 "		
5 "		
6 "		
7 "		
8 mud		
9 "		
10 14' m, 7' s.		
11 mud		
12 mix, 4' s.		
13 15' " 10' s.		
14 10' sand		

Information upon completion of well:

(1) Diameter 2 inches.

(2) Total Depth 282 feet.

(3) Water Level 12 feet below top of ground.

(4) Cased to _____, Size _____


(5) Screen: Size 08, Length 10

(6) Were any formations sealed against pollution?
 _____ yes, _____ no.

If YES depth of formation _____

Why _____

Drillers Remarks: _____

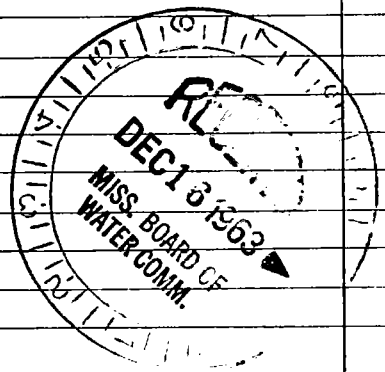

(Use Back Side)

Well No.

