

HAR.

M

2060

8-23-63

WATER WELL DRILLERS LOG

Date: 8-23, 1963, Driller: C. T. SWITZER WELL CO.

County: Harrison

(Name)

(1) Owner of Land: James Peavy  
 (Name)  
Harold St. Hubert  
 (Address)

(2) Location: 1/4, 1/4, Sec. 19 T. 9 R.  
 \_\_\_\_\_ miles \_\_\_\_\_ of \_\_\_\_\_  
 (distance) (direction) (Nearest Town)

(3) Topography: \_\_\_\_\_  
 (Hilly) (Flat) (Level)

(4) Purpose of Well: Domestic  
 (Domestic Irrigation  
 Municipal, Industrial, Other)

Description & Color of Materials Sand, Clay, Red Clay, Shell, etc.		Thick- ness Feet
0-34	clay	
34-60	sand	
60-80	clay & sand	
80-100	sand good	
100-110	clay	
110-140	sand, hard good	
140-140	hard clay	
140-239	clay	
239-240	sand	
240-255	sand, fine fine	

Information upon completion of well:

(1) Diameter 2 inches.

(2) Total Depth 258' feet.

(3) Water Level top of ground feet below top of ground.

(4) Cased to 258', Size 2"

(5) Screen: Size 2", Length 10'

(6) Were any formations sealed against pollution?  
 yes, \_\_\_\_\_ no.


If YES depth of formation \_\_\_\_\_

Why hard clay, impervious

Drillers Remarks: \_\_\_\_\_

\_\_\_\_\_

\_\_\_\_\_

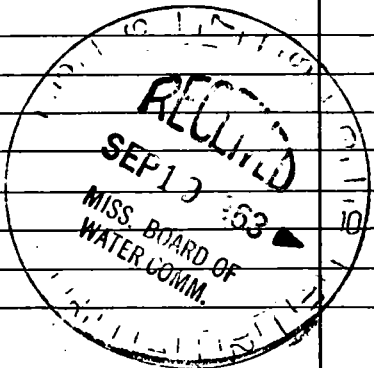

(Use Back Side)

Well No.

