

HAR.  
M 2062  
9-10-63

WATER WELL DRILLERS LOG

Date: 9-10, 1963, Driller: C. T. SWITZER WELL CO. County: Howland

(Name)

(1) Owner of Land: Hold Key Range  
(Name)

W. Beach, Biloxi  
(Address)

(2) Location: 1/4, 1/4, Sec. 7 CO T R  
\_\_\_\_\_ miles \_\_\_\_\_ of \_\_\_\_\_  
(distance) (direction) (Nearest Town)

(3) Topography: Flat  
(Hilly) (Flat) (Level)

(4) Purpose of Well: Domestic  
(Domestic Irrigation  
Municipal, Industrial, Other)

Description & Color of Materials Sand, Clay, Red Clay, Shell, etc.		Thick- ness Feet
<u>10-18</u>	<u>sand</u>	
<u>18-72</u>	<u>clay</u>	
<u>72-99</u>	<u>sand</u>	
<u>99-133</u>	<u>clay, soft</u>	
<u>133-155</u>	<u>sand</u>	
<u>155-178</u>	<u>clay</u>	
<u>178-180</u>	<u>sand</u>	
<u>180-200</u>	<u>sand, fine</u>	
<u>200-250</u>	<u>sand, gold</u>	

Information upon completion of well:

(1) Diameter 2 inches.

(2) Total Depth 230 feet.

(3) Water Level 6' 4" feet below top of ground.


(4) Cased to 230', Size 2"

(5) Screen: Size 2", Length 10'

(6) Were any formations sealed against pollution?  
 yes,  no.

If YES depth of formation \_\_\_\_\_  
Why North West requirement

Drillers Remarks: \_\_\_\_\_  
\_\_\_\_\_  
\_\_\_\_\_

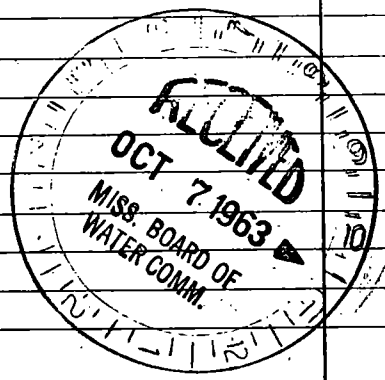

(Use Back Side)

Retain this copy for your office files.

Well No.

1874

1874

