

M 2063 A 104805  
 9-12-63

WATER WELL DRILLERS LOG

Date: 9-14, 1963, Driller: C. T. SWITZER WELL CO. County: Norfolk  
 (Name)

(1) Owner of Land: M. J. Ryan  
 (Name)  
111 Hwy 64, Blakely  
 (Address)

(2) Location: 1/4, 1/4 Sec. T. R.  
9 7 9  
 miles of (distance) (direction) (Nearest Town)

(3) Topography: Level  
 (Hilly) (Flat) (Level)

(4) Purpose of Well: Domestic  
 (Domestic Irrigation  
 Municipal, Industrial, Other)

Description & Color of Materials Sand, Clay, Red Clay, Shell, etc.	Thick- ness Feet
<u>10-19</u>	<u>sand</u>
<u>19-38</u>	<u>clay</u>
<u>38-114</u>	<u>sand</u>
<u>114-138</u>	<u>clay</u>
<u>138-140</u>	<u>sand</u>
<u>140-160</u>	<u>sand, fine</u>
<u>160-189</u>	<u>sand</u>
<u>189-334</u>	<u>clay</u>
<u>334-348</u>	<u>sand</u>

Information upon completion of well:

(1) Diameter: 2 inches.

(2) Total Depth: 348 feet.

(3) Water Level: 26' feet below top of ground.


(4) Cased to: 348', Size 2"

(5) Screen: Size 2", Length 10'

(6) Were any formations sealed against pollution?  
 yes,  no.

If YES depth of formation \_\_\_\_\_  
 Why Handwritten note

Drillers Remarks: \_\_\_\_\_

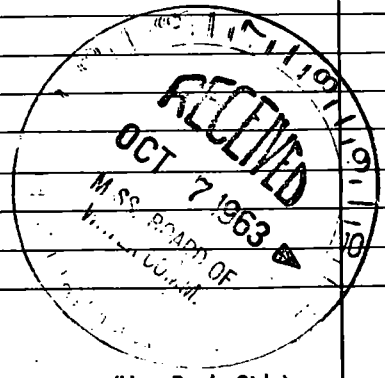

(Use Back Side)

Well No.

