

HAR.
M
10-7-63

2064 WATER WELL DRILLERS LOG

Date: 10-7-63, 1963, Driller: G. T. SWITZER WELL CO. County: Harrison

(Name)

(1) Owner of Land: Andrew Baker
(Name)

218 North 1st Ave City
(Address)

(2) Location: 7/10 Sec. T R R

 miles of
(distance) (direction) (Nearest Town)

(3) Topography: (Hilly) (Flat) (Level)

(4) Purpose of Well: Commercial
(Domestic Irrigation
Municipal, Industrial, Other)

Description & Color of Materials
Sand, Clay, Red Clay, Shell, etc.

Thick-
ness
Feet

30-34 sand	
34-64 mud	
64-48 sand	
48-130 clay	
130-144 sand	
144-245 clay	
245-266 clay w/sand & sh	
266-347 clay	
347-367 clay w/sand & sh	
367-387 clay	
387-408 clay w/sand & sh	
408-485 clay	
485-504 sand	
504-510 clay	
510-590 sand w/ sh	
590-550 sand	
550-566 clay w/sand	
566-633 sand	

Information upon completion of well:

(1) Diameter 2 1/4 inches.

(2) Total Depth 633 feet.

(3) Water Level 8 1/2' feet below top of ground.

(4) Cased to 633', Size 2 1/4"


(5) Screen: Size 2", Length 30'

(6) Were any formations sealed against pollution?
 yes, no.

If YES depth of formation

Why Health Dept. requirement

Drillers Remarks:

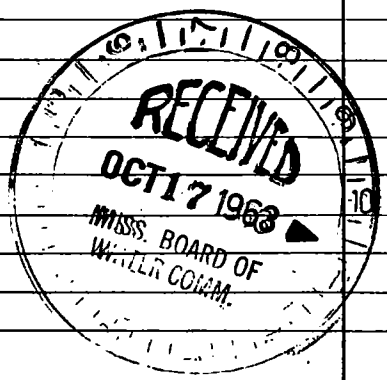

(Use Back Side)

Well No.

1894

Received of Mr. J. H. ...

the sum of ...

for ...

...

...

...