

HAR.
M 2065
10-30-63

WATER WELL DRILLERS LOG

Date: 10-30, 1963, Driller: C. T. SWITZER WELL CO. County: Harrison

(Name)

(1) Owner of Land: Wellington Moore
(Name)
De Bump Rd, Baloxi
(Address)

(2) Location: 710 T R
710 miles of
(distance) (direction) (Nearest Town)

(3) Topography: Flat
(Hilly) (Flat) (Level)

(4) Purpose of Well: Domestic
(Domestic Irrigation
Municipal, Industrial, Other)


Description & Color of Materials Sand, Clay, Red Clay, Shell, etc.	Thick- ness Feet
<u>sand</u>	<u>00-42</u>
<u>clay</u>	<u>42-63</u>
<u>sand</u>	<u>63-163</u>
<u>clay</u>	<u>163-200</u>
<u>sand</u>	<u>200-224</u>

Information upon completion of well:

- (1) Diameter 2 inches.
- (2) Total Depth 226 feet.
- (3) Water Level 23' feet below top of ground.
- (4) Cased to 226', Size 2"
- (5) Screen: Size 2", Length 10'
- (6) Were any formations sealed against pollution?
✓ yes, no.

If YES depth of formation
Why Health Dept. requirements

Drillers Remarks:

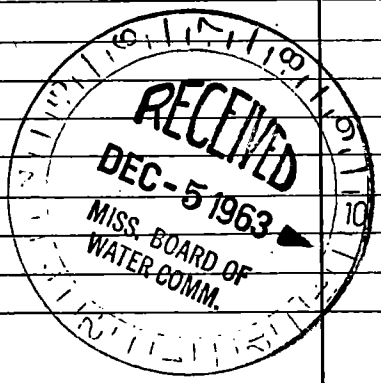

(Use Back Side)

Well No.

1847

1847

Received of Mr. J. M. Smith
the sum of \$100.00

for Rent

1847

11

1

1847