

M 2066
1-6-64

B 389 06
WATER WELL DRILLERS LOG

15

Date: 1-6, 1964 Driller: C. T. SWITZER WELL CO. County: Harrison

(1) Owner of Land: Clay Gaylor
(Name)
N.W. 1/4 Sec. 15 - Biloxi
(Address)

(2) Location: 1/4, 1/4, Sec. 79, T. R
Sub Dry
miles (distance), of (direction), (Nearest Town)

(3) Topography: ✓
(Hilly) (Flat) (Level)

(4) Purpose of Well: Domestic
(Domestic Irrigation, Municipal, Industrial, Other)

Description & Color of Materials Sand, Clay, Red Clay, Shell, etc.	Thick- ness Feet	Depth Feet
clay	00	20
sand	20	28
clay	28	40
clay & fine sand	40	60
sand, fine	60	100
sand, good	100	136
clay	136	180
sand, fine	180	195
clay	195	220
sand, fine	220	235
clay	235	278
sand	278	280
sand, fine	280	300
sand, good	300	341

Information upon completion of well:

(1) Diameter 2 inches.

(2) Total Depth 341 feet.

(3) Water Level 5' feet below top of ground.

(4) Cased to 341', Size 2"


(5) Screen: Size 2", Length 10'

(6) Were any formations sealed against pollution?
✓ yes, no.

If YES depth of formation _____

Why: Health Dept. Requirements

Drillers Remarks: _____

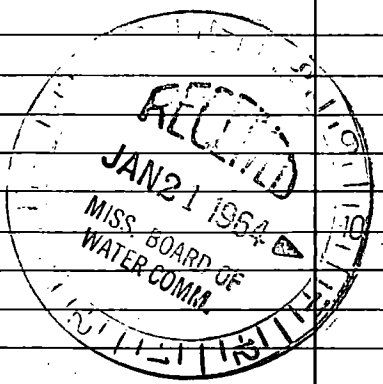

(Use Back Side)

Well No.

