

M 2069
2-5-64

WATER WELL DRILLERS LOG

Date: 2-5, 1964, Driller: C. T. SWITZER WELL CO. County: Harrison
(Name)

(1) Owner of Land: Doty Annemie
(Name)
118 Annemie Ave Biloxi
(Address)

(2) Location: 1/4, 1/4, Sec. 7 R 9
_____ miles _____ of _____
(distance) (direction) (Nearest Town)

(3) Topography: (Hilly) (Flat) (Level)

(4) Purpose of Well: Commercial
(Domestic Irrigation Municipal, Industrial, Other)

Description & Color of Materials Sand, Clay, Red Clay, Shell, etc.	Thick- ness Feet	Depth Feet
clay	00	07
sand	07	12
clay	12	24
sand & clay mixed	24	34
clay	34	82
clay w/ sand stks	82	105
clay	105	132
sand, fine	132	145
clay	145	152
shale & sand	152	170
clay w/ sand stks	170	212
clay	212	235
clay w/ sand stks	235	257
clay	257	301
clay w/ sand stks	301	323
clay	323	326
sand	326	331
clay	331	430
clay w/ sand stks	430	455
clay	455	497
shale w/ sand stks	497	517
sand w/ shale	517	539
sand	539	569
shale	569	625
sand	625	672
sand w/ stks	672	694
shale	694	774
sand	774	860

Information upon completion of well:

(1) Diameter 3 1/4 inches.

(2) Total Depth 860 feet.

(3) Water Level 15' 4" feet below top of ground.

(4) Cased to 860', Size 3 1/4"


(5) Screen: Size 3", Length 30'

(6) Were any formations sealed against pollution?
 yes, no.

If YES depth of formation _____

Why Harrison Dept. requirements

Drillers Remarks: _____

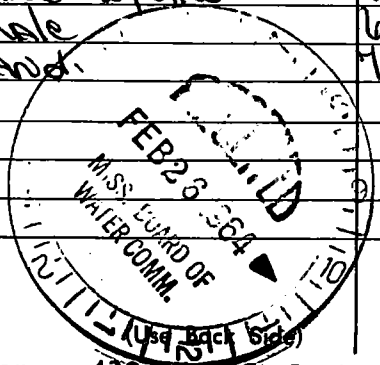

Well No.

111 8 A

111 8 A

111 8 A

111 8 A