

HAR.

M 2070

3-2-64

WATER WELL DRILLERS LOG

Date: 3/12, 1964, Driller: C. T. Switzer County Harrison

(Name)

(1) Owner of Land: C. A. Rudinich (Name)

70 Below, Old Hwy 90 (Address)

(2) Location: 1/4, 1/4, Sec. 99 T. R.

(distance) (direction) (Nearest Town)

(3) Topography: (Hilly) (Flat) (Level)

(4) Purpose of Well: Domestic (Domestic Irrigation, Municipal, Industrial, Other)

Description & Color of Materials Sand, Clay, Red Clay, Shell, etc.	Thick- ness Feet	Depth Feet
clay	20	20
sand, fine	20	40
clay, fine	40	80
sand	28	108
clay	60	168
sand	15	183
clay	26	209
sand, fine	10	219
clay	12	231
clay & sand etc	10	241
sand, fine	18	259

Information upon completion of well:

(1) Diameter 2 inches.

(2) Total Depth 259 feet.

(3) Water Level 9' feet below top of ground.

(4) Cased to 259', Size 2x3"


(5) Screen: Size 2", Length 15'

(6) Were any formations sealed against pollution? yes, no.

If YES depth of formation

Why Health Dept. requirement

Drillers Remarks:

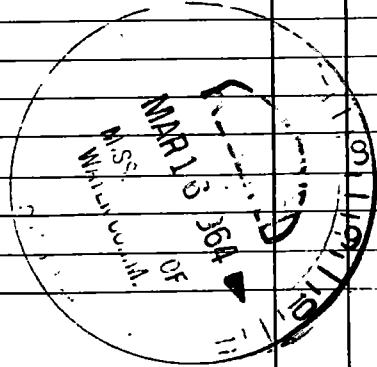

(Use Back Side)

Well No.

