

HAR.

MISSISSIPPI BOARD OF WATER COMMISSIONERS

M 2071

3-21-64

WATER WELL DRILLERS LOG

C. T. SWITZER WELL CO.

Date: 3-21, 1964, Driller: \_\_\_\_\_ County: Harrison

(Name)

(1) Owner of Land: W. H. H. Harrison  
(Name)

Big Ridge Rd. Belair  
(Address)

(2) Location: \_\_\_\_\_ 1/4, \_\_\_\_\_ 1/4, Sec. 79  
\_\_\_\_\_ miles \_\_\_\_\_ of \_\_\_\_\_  
(distance) (direction) (Nearest Town)

(3) Topography: \_\_\_\_\_  
(Hilly) (Flat) (Level)

(4) Purpose of Well: Domestic  
(Domestic Irrigation Municipal, Industrial, Other)

Description & Color of Materials Sand, Clay, Red Clay, Shell, etc.	Thick- ness Feet	Depth Feet
sand	00	05
clay	05	20
sand	20	30
clay	30	40
sand, good	40	100
sand	100	105
clay	105	110
clay & fine sand etc	110	160
clay	160	190
sand, fine	190	200
clay, fine	200	300
sand, fine	300	310
clay	310	330
sand	330	340
clay & shells	340	360
clay	360	480
clay & rocks	480	520
fine sand, 2 rocks	520	540
clay	540	584
sand, good	584	584

Information upon completion of well:

(1) Diameter 2" inches.

(2) Total Depth 584' feet.

(3) Water Level 13' feet below top of ground.

(4) Cased to 584', Size 2"


(5) Screen: Size 2", Length 10'

(6) Were any formations sealed against pollution?  
 yes, \_\_\_\_\_ no.

If YES depth of formation \_\_\_\_\_

Why Health Dept. requirements

Drillers Remarks: \_\_\_\_\_

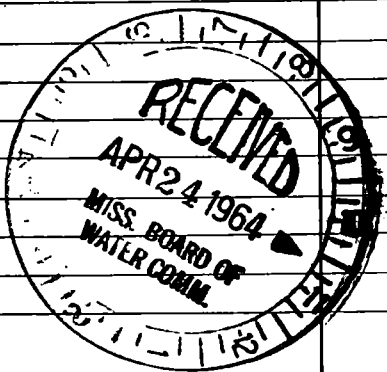

(Use Back Side)

Well No.

