

M 2073 M

WATER WELL DRILLERS LOG

4-24-64

C. T. SWITZER WELL CO.

Date: 4-24, 1964, Driller: \_\_\_\_\_ County: Harrison

(Name)

(1) Owner of Land: Morgan Jones  
 (Name)  
Papp's Ferry Rd.  
 (Address)

(2) Location: \_\_\_\_\_ 1/4, \_\_\_\_\_ 1/4, Sec. 7 10  
 T. R.  
 \_\_\_\_\_ miles \_\_\_\_\_ of \_\_\_\_\_  
 (distance) (direction) (Nearest Town)

(3) Topography: \_\_\_\_\_  
 (Hilly) (Flat) (Level)

(4) Purpose of Well: Domestic  
 (Domestic Irrigation  
 Municipal, Industrial, Other)

Description & Color of Materials Sand, Clay, Red Clay, Shell, etc.	Thick- ness Feet	Depth Feet
clay	00	05
sand	05	20
clay	20	50
sand	50	72
clay	72	90
sand	90	100
sand, red	100	110
clay	110	220
clay w/ few shells	220	240
clay	240	290
sand, good	290	302
clay	302	355
sand, good	355	390

Information upon completion of well:

(1) Diameter 2 inches.

(2) Total Depth 390 feet.

(3) Water Level 39' - 4" feet below top of ground.


(4) Cased to 390', Size 2"

(5) Screen: Size 2", Length 10'

(6) Were any formations sealed against pollution?  
 yes, \_\_\_\_\_ no.

If YES depth of formation \_\_\_\_\_  
 Why Health Dept. requirement

Drillers Remarks: \_\_\_\_\_

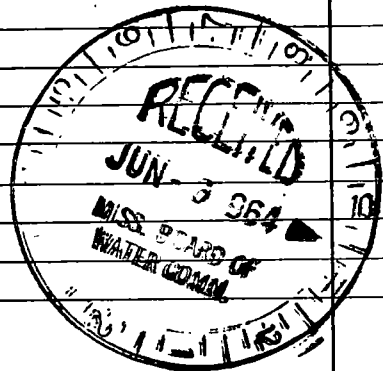

(Use Back Side)

Well No.

