

HAR.

M 20 74

5-4-64

WATER WELL DRILLERS LOG

Date: 5-4, 1964, Driller: C. T. SWITZER WELL CO. County: Noxubee

(Name)

(1) Owner of Land: M. Rushing
 (Name)
320 Central Ave. Biloxi
 (Address)

(2) Location: 1/4, 1/4, Sec 2879 T R
 (distance) (direction) (Nearest Town)

(3) Topography: Level
 (Hilly) (Flat) (Level)

(4) Purpose of Well: Domestic
 (Domestic Irrigation, Municipal, Industrial, Other)

Description & Color of Materials Sand, Clay, Red Clay, Shell, etc.	Thick- ness Feet	Depth Feet
clay	00	10
sand	10	16
clay	16	28
sand, fine	28	38
clay	38	53
sand, fine, & clay	53	75
clay w/ sand sh	75	94
sand, fine	94	119
clay	119	144
shale	144	175
sand, fine	175	250
sand	250	342
shale	342	392
sand	392	397
shale	397	434
shale & fine sand	434	456
shale	456	548
sand	548	595
shale	595	681
sand	681	741
shale & sand sh	741	732
sand	732	876

Information upon completion of well:

(1) Diameter 3" inches.

(2) Total Depth 871 feet.

(3) Water Level 13' feet below top of ground.

(4) Cased to 841', Size 3"


(5) Screen: Size 3", Length 15'

(6) Were any formations sealed against pollution?
 yes, no.

If YES depth of formation _____

Why Health Dept. requirements

Drillers Remarks: _____

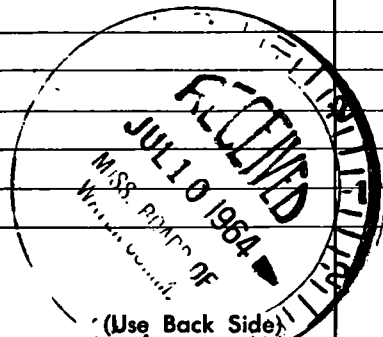

Well No.

