

HAR.

M 20⁷⁵

5-11-64

WATER WELL DRILLERS LOG

G. T. SWITZER WELL CO.

Date: 5-11, 1964, Driller: County: [Signature]

(Name)

(1) Owner of Land: [Signature] National Bank (Name)

[Signature] (Address)

(2) Location: 1/4, 1/4, Sec. 7 10 T. R.

(distance) miles (direction) of (Nearest Town)

(3) Topography: (Hilly) (Flat) (Level)

(4) Purpose of Well: Commercial (Domestic Irrigation Municipal, Industrial, Other)

Information upon completion of well:

(1) Diameter 3x2 inches.

(2) Total Depth 840 feet.

(3) Water Level 18' feet below top of ground.

(4) Cased to 840', Size 3x2"

(5) Screen: Size 2", Length 15'

(6) Were any formations sealed against pollution?


yes, no.

If YES depth of formation

Why: Health Dept. requirement

Drillers Remarks:

Table with 4 columns: Description & Color of Materials, Thickness Feet, Depth Feet. Rows include sand, clay, sand & clay, etc.

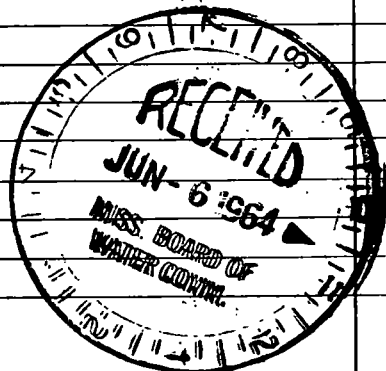

(Use Back Side)

Well No.

