

MISSISSIPPI BOARD OF WATER COMMISSIONERS

HAR.

M 2077
7-3-64

M A 104512
WATER WELL DRILLERS LOG

Date: 7-3-64, 19___, Driller: F. T. SWITZER WELL CO. County: Winn

(Name)

(1) Owner of Land: Morgan Seymour
(Name)

W side of old Hwy 57 just S of
Rodew site
(Address)

(2) Location: ___ 1/4, ___ 1/4, Sec. ___ T ___ R ___
9 7 9
miles ___ of ___
(distance) (direction) (Nearest Town)

(3) Topography: (Hilly) (Flat) (Level)

(4) Purpose of Well: Domestic
(Domestic Irrigation, Municipal, Industrial, Other)

Description & Color of Materials Sand, Clay, Red Clay, Shell, etc.	Thick- ness Feet	Depth Feet
<u>Drilled deeper 7-3-64</u>		
<u>Clay</u>	<u>335</u>	<u>368</u>
<u>Sand, fine</u>	<u>368</u>	<u>388</u>
<u>Sand w/ clay str</u>	<u>388</u>	<u>408</u>
<u>Sand</u>	<u>408</u>	<u>484</u>
<u>Clay</u>	<u>484</u>	<u>509</u>
<u>Clay + sand str</u>	<u>509</u>	<u>530</u>
<u>Clay</u>	<u>530</u>	<u>590</u>
<u>Clay + shale</u>	<u>590</u>	<u>610</u>
<u>Clay</u>	<u>610</u>	<u>691</u>
<u>Clay + shale</u>	<u>691</u>	<u>711</u>
<u>Sand</u>	<u>711</u>	<u>793</u>
<u>Sand, extn good</u>	<u>793</u>	<u>868</u>
<u>Clay</u>	<u>868</u>	<u>956</u>
<u>Clay + shale</u>	<u>956</u>	<u>976</u>
<u>Shale</u>	<u>976</u>	<u>1039</u>
<u>Clay</u>	<u>1039</u>	<u>1067</u>
<u>Sand</u>	<u>1067</u>	<u>1082</u>
<u>Clay + Shales</u>	<u>1082</u>	<u>1102</u>
<u>Sand str</u>	<u>1102</u>	<u>1124</u>
<u>Sand</u>	<u>1124</u>	<u>1201</u>


Information upon completion of well:

- (1) Diameter 2" inches.
- (2) Total Depth 1200 feet.
- (3) Water Level 28 + feet below top of ground.
- (4) Cased to 1200', Size 2"
- (5) Screen: Size 2", Length 30'
- (6) Were any formations sealed against pollution?

yes, no.

If YES depth of formation _____
Why Health, ^{not} Requirements

Drillers Remarks: _____

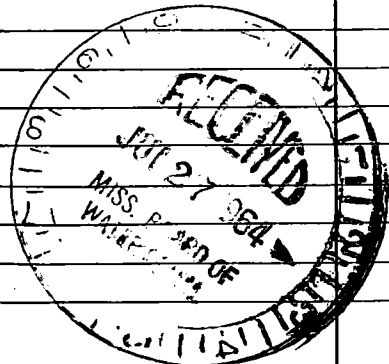

(Use Back Side)

Well No.

