

HAR.

M 2078 M

7-8-64

WATER WELL DRILLERS LOG

Date: July 8, 1964, Driller: C. T. SWITZER WELL CO. County \_\_\_\_\_

(Name)

(1) Owner of Land: C. G. Esche

(Name)

422 Ross Truck Road  
(Address) Below Main

(2) Location: \_\_\_\_\_ 1/4, \_\_\_\_\_ 1/4, Sec. T. 1 R. 9

\_\_\_\_\_ miles \_\_\_\_\_ of \_\_\_\_\_  
(distance) (direction) (Nearest Town)

(3) Topography: \_\_\_\_\_  (Hilly) \_\_\_\_\_ (Flat) \_\_\_\_\_ (Level)

(4) Purpose of Well: Domestic  
(Domestic Irrigation  
Municipal, Industrial, Other)

Information upon completion of well:


- (1) Diameter 2 inches.
- (2) Total Depth 295 feet.
- (3) Water Level 11' 7" feet below top of ground.
- (4) Cased to 295', Size 2"
- (5) Screen: Size 8 ga, Length 10'
- (6) Were any formations sealed against pollution?  
X yes, \_\_\_\_\_ no.

If YES depth of formation \_\_\_\_\_

Why Health Dept Reagents

Drillers Remarks: \_\_\_\_\_

Description & Color of Materials Sand, Clay, Red Clay, Shell, etc.	Thick- ness Feet	Depth Feet
<u>Clay</u>	<u>00</u>	<u>15</u>
<u>Sand</u>	<u>15</u>	<u>30</u>
<u>Clay</u>	<u>30</u>	<u>80</u>
<u>Sand, good</u>	<u>80</u>	<u>100</u>
<u>Sand</u>	<u>100</u>	<u>115</u>
<u>Clay, good</u>	<u>115</u>	<u>120</u>
<u>Clay</u>	<u>120</u>	<u>198</u>
<u>Sand</u>	<u>198</u>	<u>200</u>
<u>Sand w/ clay str</u>	<u>200</u>	<u>220</u>
<u>Clay</u>	<u>220</u>	<u>255</u>
<u>Sand</u>	<u>255</u>	<u>260</u>
<u>Sand, good</u>	<u>260</u>	<u>295</u>

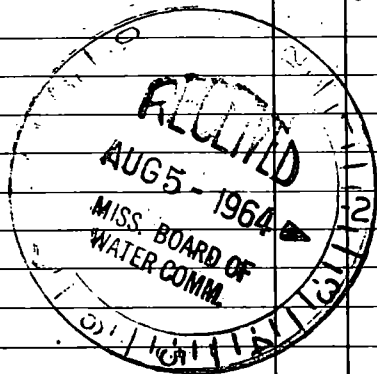

Well No.

(Use Back Side)

