

M 2081

10-23-64 WATER WELL DRILLERS LOG

Date: 10-23, 1964, Driller: C. T. SWITZER WELL CO. County: Harrison

(Name)

(1) Owner of Land: Bud's Driller Co (Name)

Rapp's Ferry Rd, Biloxi (Address)

(2) Location: 1/4, 1/4, Sec. 7 10 T R (distance) (direction) (Nearest Town)

(3) Topography: (Hilly) (Flat) (Level)

(4) Purpose of Well: Commercial (Domestic Irrigation Municipal, Industrial, Other)


Table with 4 columns: Description & Color of Materials (Sand, Clay, Red Clay, Shell, etc.), Thickness Feet, Depth Feet. Rows contain handwritten entries like 'sand', 'clay', 'sand & fine', etc.

Information upon completion of well:

- (1) Diameter 2x3 inches.
(2) Total Depth 546 feet.
(3) Water Level 4 feet below top of ground.
(4) Cased to 546', Size 2x3"
(5) Screen: Size 2", Length 21'
(6) Were any formations sealed against pollution? yes, no.

If YES depth of formation Why Health Dept. requirements

Drillers Remarks:

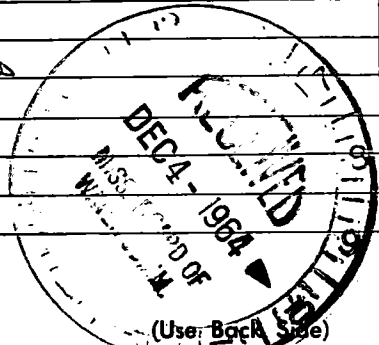

Well No.

