

HAR.

MISSISSIPPI BOARD OF WATER COMMISSIONERS

M

11-5-64

2087

WATER WELL DRILLERS LOG

Date: 11-5-64, 19___, Driller: Suntzer Well Co. County Harrison

(Name)

(1) Owner of Land: Rudy Saurin

(Name)

Cedar Lake Road Box 2

(Address)

Belox Miss

(2) Location: ___ 1/4, ___ 1/4, Sec. T7 R10

___ miles ___ of ___
(distance) (direction) (Nearest Town)

(3) Topography: (Hilly) (Flat) (Level)


(4) Purpose of Well: Domestic
(Domestic Irrigation, Municipal, Industrial, Other)

Information upon completion of well:

- (1) Diameter 2" inches.
- (2) Total Depth 317 feet.
- (3) Water Level 9- feet below top of ground.
- (4) Cased to 317', Size 2"
- (5) Screen: Size 2", Length 15'
- (6) Were any formations sealed against pollution?
 yes, ___ no.

If YES depth of formation _____
 Why Health Dept. Reports
 Drillers Remarks: _____

Description & Color of Materials Sand, Clay, Red Clay, Shell, etc.	Thick- ness Feet	Depth Feet
Clay	0	5
Sand	5	21
Clay	21	41
Sand	41	61
Clay	61	101
Sand, good	101	121
Clay	121	201
Clay, hard	201	241
Sand, fine	241	261
Sand, fair	261	281
Sand + few gravel	281	301
Sand + gravel	301	317

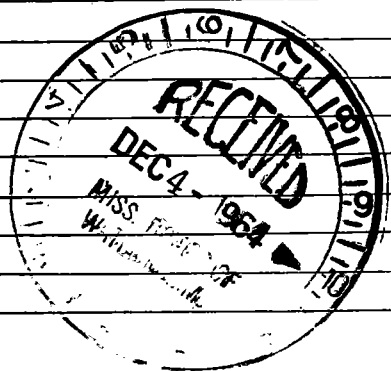

(Use Back Side)

Well No.

