

MAP.

MISSISSIPPI BOARD OF WATER COMMISSIONERS

M

2084

1-65

WATER WELL DRILLERS LOG

M

Date: Jan, 1965, Driller: C. T. Surtzow Well Co County Harrison

(Name)

(1) Owner of Land: Fountain Apts (Name)

Ab Bays Rd between Pass Rd + Highway 90 (Address)

(2) Location: 1/4, 1/4, Sec. T. 7 R. 10

miles of (distance) (direction) (Nearest Town)

(3) Topography: (Hilly) (Flat) (Level)

(4) Purpose of Well: Commercial (Domestic Irrigation Municipal, Industrial, Other)

Information upon completion of well:

(1) Diameter 4x3 inches. 63' 4 inches

(2) Total Depth 684 feet.

(3) Water Level 10' - feet below top of ground.

(4) Cased to 684, Size

(5) Screen: Size 3", Length 20'

(6) Were any formations sealed against pollution?


X yes, no.

If YES depth of formation

Why Health Dept Requirements

Drillers Remarks:

Description & Color of Materials Sand, Clay, Red Clay, Shell, etc.	Thick- ness Feet	Depth Feet
Sand	0	46
Clay + sand mixed	46	66
Clay	66	147
Mixed sand + clay	147	170
Sand	170	185
Clay	185	192
Mixed	192	202
Sand, fair	202	229
Clay	229	236
Mixed sand + clay	236	258
Soft clay	258	279
Clay	279	476
Mixed sand + clay	476	487
Sand, fair	487	508
Clay	508	520
Clay + sand streaks	520	538
Clay	538	581
Sand, fair	581	604
Sand, good	604	646
Sand, fine gravel	646	684

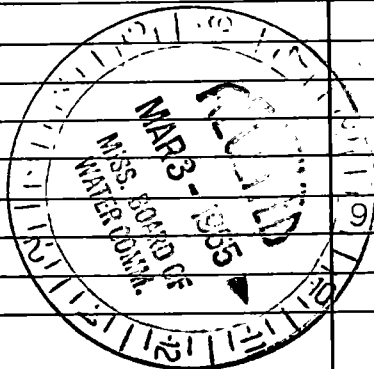

(Use Back Side)

Well No.

