

HAR.

MISSISSIPPI BOARD OF WATER COMMISSIONERS

M 2085

1-13-65

WATER WELL DRILLERS LOG

Date: 1-13, 1965, Driller: Hattiesburg Butte County Garrison

(Name)

(1) Owner of Land: Chester Loubet

(Name)

M. B. Lopez

(Address)

(2) Location: 1/4, 1/4, Sec. 79

By St Martin School

miles of (Nearest Town)

(3) Topography: X

(Hilly) (Flat) (Level)

(4) Purpose of Well: Domestic

(Domestic Irrigation Municipal, Industrial, Other)

Description & Color of Materials Sand, Clay, Red Clay, Shell, etc.

Thickness Feet

Depth Feet

yellow clay 0-15

white sand 15-25

yellow clay 25-38

Blue clay 38-64

Blue sand 64-68

Blue clay 68-72

Blue sand 72-87

Blue clay 87-110

Blue sand 110-152

Blue clay 152-202

Blue sand 202-234

Blue clay 234-255

Blue sand 255-262

Information upon completion of well:

(1) Diameter 2 inches.

(2) Total Depth 262 feet.

(3) Water Level 18 feet below top of ground.

(4) Cased to \_\_\_\_\_, Size \_\_\_\_\_

(5) Screen: Size 10 1/2", Length 10'


(6) Were any formations sealed against pollution?

yes, X no.

If YES depth of formation \_\_\_\_\_

Why \_\_\_\_\_

Drillers Remarks: \_\_\_\_\_

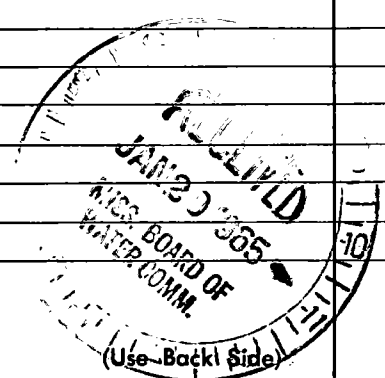

Well No.

