

HAR.

MISSISSIPPI BOARD OF WATER COMMISSIONERS


M

7086

2-26-65

WATER WELL DRILLERS LOG

Date: 2-26-65, 19___, Driller: C. T. Surtow Well Co. County Harrison

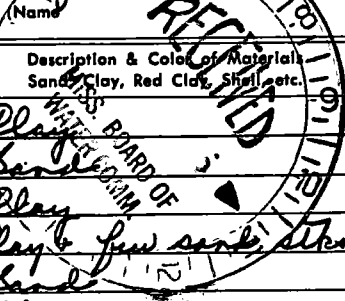

(1) Owner of Land: S. K. Manuel (Name)

Laney Bridge Road W. Belok (Address)

(2) Location: 1/4, 1/4, Sec. 79 T. R. miles of (distance) (direction) (Nearest Town)

(3) Topography: (Hilly) (Flat) (Level)

(4) Purpose of Well: Domestic (Domestic Irrigation, Municipal, Industrial, Other)

Table with columns: Description & Color of Material, Sand, Clay, Red Clay, Shell, etc.; Thickness Feet; Depth Feet. Rows contain handwritten entries: Clay, Sand, Clay, Clay & few sand, Sand, Clay, Sand, good.

Information upon completion of well:

- (1) Diameter 2" inches.
(2) Total Depth 134 feet.
(3) Water Level 25'7" feet below top of ground.
(4) Cased to 134, Size 2"
(5) Screen: Size 2", Length 10' 8 ga.
(6) Were any formations sealed against pollution? X yes, no.

If YES depth of formation
Why Health Dept. Reports

Drillers Remarks:

(Use Back Side)

Well No.

