

HAR.

MISSISSIPPI BOARD OF WATER COMMISSIONERS

M 2089  
5-31-65

WATER WELL DRILLERS LOG

Date: 5-31-65, 19\_\_\_, Driller: C. T. Surtz Well & County Harrison  
(Name)

	Description & Color of Materials Sand, Clay, Red Clay, Shell, etc.	Thick- ness Feet	Depth Feet
(1) Owner of Land: <u>W. O. B. Lee</u> (Name)	<u>Sand</u>	0	24
<u>1484 East Beach Miss. City</u> (Address)	<u>Clay</u>	24	34
(2) Location: <u>1/4, 1/4, Sec. T 1 R 10</u> <u>Miss</u>	<u>Sand + gravel</u>	34	44
_____ miles _____ of _____ (distance) (direction) (Nearest Town)	<u>Clay</u>	44	147
(3) Topography: _____ (Hilly) (Flat) (Level)	<u>Sand</u>	147	168
(4) Purpose of Well: <u>Domestic</u> (Domestic Irrigation Municipal, Industrial, Other)	<u>Clay</u>	168	192
	<u>Mixed sand + clay</u>	192	236
	<u>Clay</u>	236	433
	<u>Sand, good</u>	433	492


Information upon completion of well:

- (1) Diameter 2" inches.
- (2) Total Depth 489 feet.
- (3) Water Level 2' 6" + feet below top of ground.
- (4) Cased to 492, Size 2"
- (5) Screen: Size 2", Length 15' 8"
- (6) Were any formations sealed against pollution?  
X yes, \_\_\_\_\_ no.

If YES depth of formation \_\_\_\_\_

Why Health Dept. Reports

Drillers Remarks: \_\_\_\_\_

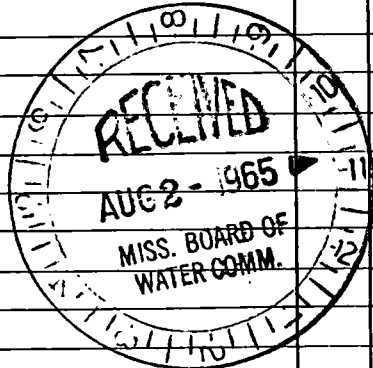

(Use Back Side)

Well No.

67

---

484