

M 2090
6-16-65

WATER WELL DRILLERS LOG

Date: 6-16, 1965, Driller: C. J. Suter, Well Co. County: Jefferson
(Name)

(1) Owner of Lands: George Fisher
(Name)
311 St. Martin Rd, Balak
(Address)

(2) Location: 79 $\frac{1}{4}$, $\frac{1}{4}$, Sec. T R
miles _____ of _____
(distance) (direction) (Nearest Town)

(3) Topography: ✓
(Hilly) (Flat) (Level)

(4) Purpose of Well: Domestic
(Domestic Irrigation
Municipal, Industrial, Other)

Description & Color of Materials Sand, Clay, Red Clay, Shell, etc.	Thick- ness Feet	Depth Feet
clay	00	16
sand	16	33
clay	33	241
sand, good	241	251

Information upon completion of well:

(1) Diameter 2 inches.

(2) Total Depth 251 feet.

(3) Water Level 10' feet below top of ground.


(4) Cased to 251', Size 2"

(5) Screen: Size 2", Length 10'

(6) Were any formations sealed against pollution?
✓ yes, _____ no.

If YES depth of formation _____
Why Health Dept. requirement

Drillers Remarks: _____

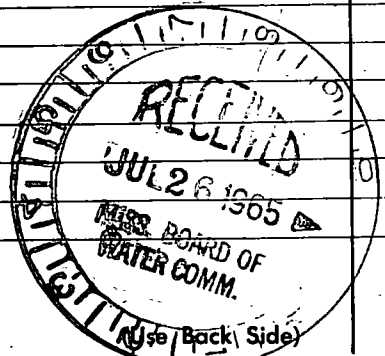

Well No.

Walt Whitman

1875
1876
1877
Walt Whitman