

M 293
7-30-65

WATER WELL DRILLERS LOG

Date: 7-30-65, 19___, Driller: C. T. Surtz Well Co County Harrison
(Name)

(1) Owner of Land: Miss Andy Page
(Name)
Route Belz
(Address)
(2) Location: ___ 1/4, ___ 1/4, Sec. ___ T 7 R 9
___ miles ___ of ___
(distance) (direction) (Nearest Town)
(3) Topography: ___ X
(Hilly) (Flat) (Level)
(4) Purpose of Well: domestic
(Domestic Irrigation
Municipal, Industrial, Other)


Description & Color of Materials Sand, Clay, Red Clay, Shell, etc.	Thick- ness Feet	Depth Feet
Clay	0	21
Sand, fair	21	42
Sand	42	52
Clay	52	63
Sand, good	63	103
Sand + Clay streaks	103	124
Clay, hard	124	166
Clay	166	200
Sand	200	208
Sand, good	208	244

Information upon completion of well:

(1) Diameter 2 1/2 inches.
(2) Total Depth 243 feet.
(3) Water Level 14' - feet below top of ground.
(4) Cased to 243, Size 2"
(5) Screen: Size 2", Length 8 ft C.M.I.D.
(6) Were any formations sealed against pollution?
X yes, ___ no.

If YES depth of formation _____
Why _____

Drillers Remarks: Health Dept
Requirements

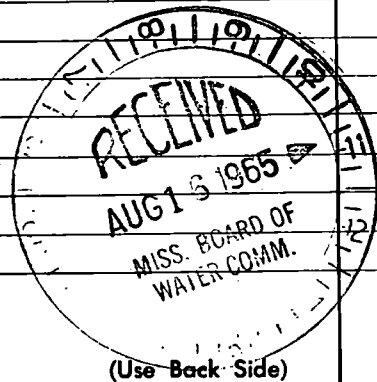

(Use Back Side)

Well No.

845