

M 2095  
9-3-65

WATER WELL DRILLERS LOG

Date: 9-3-65, 19\_\_\_, Driller: C. T. Surtgen Well Co County Harrison  
(Name)

(1) Owner of Land: Furness Place  
Co - of Water (Name) Co.  
Center Drive Henderson  
(Address)

(2) Location: 1/4, 1/4, Sec. T 7 R 10,  
\_\_\_\_\_ miles \_\_\_\_\_ of \_\_\_\_\_  
(distance) (direction) (Nearest Town)

(3) Topography: X  
(Hilly) (Flat) (Level)

(4) Purpose of Well: domestic  
(Domestic Irrigation  
Municipal, Industrial, Other)

Information upon completion of well:

(1) Diameter 4 1/2 inches.

(2) Total Depth 654 feet.

(3) Water Level 11' - \_\_\_\_\_ feet below top of ground.


(4) Cased to 654', Size 64" of 4" 590" of 2"

(5) Screen: Size 8 ga 66, Length 30'

(6) Were any formations sealed against pollution?  
X yes, \_\_\_\_\_ no.

If YES depth of formation \_\_\_\_\_  
Why Health Dept. Reagents  
Drillers Remarks: \_\_\_\_\_

Description & Color of Materials Sand, Clay, Red Clay, Shell, etc.	Thick- ness Feet	Depth Feet
Sand	0	28
Clay	28	40
Sand	40	43
Soft Clay + sand	43	66
Clay	66	86
Sand	86	87
Soft Clay + sand	87	108
Soft Clay	108	129
Clay + sand silt	129	150
Clay	150	185
Sand	185	205
Clay	205	299
Sand	299	324
Clay + sand silt	324	345
Sand	345	350
Clay	350	433
Clay, Sand	433	473
Clay	473	493
Clay + shale	493	538
Clay	538	551
Sand	551	654

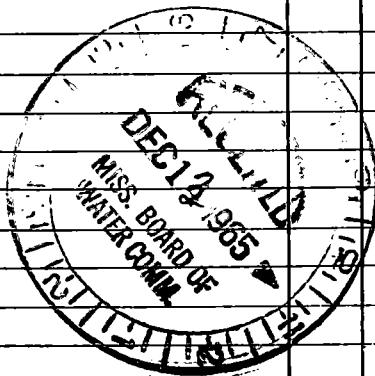

(Use Back Side)

Well No.

