

AR.. MISSISSIPPI BOARD OF WATER COMMISSIONERS

M 2096M

9-22-65 WATER WELL DRILLERS LOG

A 98512

Date: 9-22-65, Driller: C. T. Sautter, County: Harrison

(Name)

	Description & Color of Materials Sand, Clay, Red Clay, Shell, etc.	Thick- ness Feet	Depth Feet
(1) Owner of Land: <u>Kenneth Seymour</u> (Name)	Clay	0	10
<u>Sundown Road</u> (Address)	Sand	10	26
(2) Location: <u>2279</u> 1/4, 1/4, Sec. T R	Clay	26	61
_____ miles _____ of _____ (distance) (direction) (Nearest Town)	Sand, fine	61	82
(3) Topography: <u>X</u> (Hilly) (Flat) (Level)	Sand + clay streaks	82	102
(4) Purpose of Well: <u>domestic</u> (Domestic Irrigation Municipal, Industrial, Other)	Sand	102	156


Information upon completion of well:

- (1) Diameter 2" inches.
- (2) Total Depth 156' feet.
- (3) Water Level 1 1/3' feet below top of ground.
- (4) Cased to 156', Size 2"
- (5) Screen: Size Egw 46, Length 10'
- (6) Were any formations sealed against pollution?
 yes, no.

If YES depth of formation

Why Health Dept Request

Drillers Remarks:

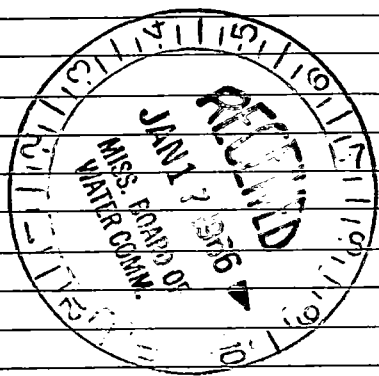

(Use Back Side)

Well No.

24 0
02 0
14 41
07 18
20 08
22 01

Handwritten notes or scribbles, possibly including the number '20'.

Faint handwritten text, possibly a signature or date.