

HAR.

M

MISSISSIPPI BOARD OF WATER COMMISSIONERS

2099

2-4-66

WATER WELL DRILLERS LOG

Date: 2-4-66, 19\_\_\_, Driller: C. T. Sauter Well Co County Harrison

(Name)

(1) Owner of Land: <u>J. Pembert Speed</u> (Name)	Description & Color of Materials Sand, Clay, Red Clay, Shell, etc.	Thick- ness Feet	Depth Feet
<u>Woolmarket - Shoucrut Rd</u> (Address)	Clay	0	9
(2) Location: ___ 1/4, ___ 1/4, Sec. <u>T 7 R 10</u>	Sand	15	22
_____ miles _____ of _____ (distance) (direction) (Nearest Town)	Clay	22	66
(3) Topography: <u>X</u> (Hilly) (Flat) (Level)	Mixed sand + clay	66	86
(4) Purpose of Well: <u>domestic</u> (Domestic Irrigation Municipal, Industrial, Other)	Sand	86	91
	Clay	91	128
	Mixed sand + clay	128	150
	Sand, fine	150	162
	Mixed	162	172
	Clay	172	193
	Sand, fine	193	201
	Mixed sand + clay	201	213
	Clay	213	220
	Sand	220	227
	Clay	227	363
	Sand	363	372
	Clay	372	447
	Sand	447	455
	Sand, fine	455	476
	Sand, good	476	514


Information upon completion of well:

- (1) Diameter 2" inches.
- (2) Total Depth 513' feet.
- (3) Water Level 6" - feet below top of ground.
- (4) Cased to 513', Size 2"
- (5) Screen: Size 8ga 66, Length 10'
- (6) Were any formations sealed against pollution?  
X yes, \_\_\_ no.

If YES depth of formation \_\_\_\_\_

Why Health Dept Report

Drillers Remarks: \_\_\_\_\_

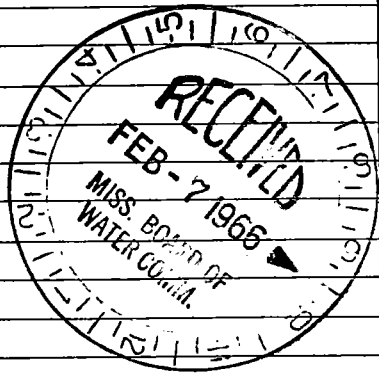

(Use Back Side)

Well No.

