

HAR. MISSISSIPPI BOARD OF WATER COMMISSIONERS

M

2100

WATER WELL DRILLERS LOG

3-17-66

Date: 3-17-66, 1966, Driller: C. T. Lutzger Well Co County Harrison  
(Name)

(1) Owner of Land: Clark Belius  
(Name)

1 1/2 miles W. Poplar Ferry Rd on N. Country Club Lane. Lot 10 of P  
(Address)

(2) Location: 1/4, 1/4, Sec. 1 T. R,  
\_\_\_\_\_ miles \_\_\_\_\_ of \_\_\_\_\_  
(distance) (direction) (Nearest Town)

(3) Topography: X  
(Hilly) (Flat) (Level)

(4) Purpose of Well: domestic  
(Domestic Irrigation  
Municipal, Industrial, Other)

| Description & Color of Materials<br>Sand, Clay, Red Clay, Shell, etc. | Thick-<br>ness<br>Feet | Depth<br>Feet |
|---|------------------------|---------------|
| Clay  | 0                      | 20            |
| Sand  | 20                     | 35            |
| Clay  | 35                     | 37            |
| Sand + gravel   | 37                     | 63            |
| Stratified  | 63                     | 98            |
| Clay  | 98                     | 153           |
| Sand  | 153                    | 156           |
| Clay  | 156                    | 315           |
| Sand  | 315                    | 321           |
| Stratified  | 321                    | 334           |
| Clay  | 334                    | 384           |
| Fullin earth  | 384                    | 407           |
| Stratified  | 407                    | 428           |
| Sand, fine  | 428                    | 438           |
| Sand, good  | 438                    | 448           |
| Sand  | 448                    | 490           |

Information upon completion of well:

(1) Diameter 2 inches.

(2) Total Depth 490 feet.

(3) Water Level 7'6" - feet below top of ground.

(4) Cased to 490, Size 2"


(5) Screen: Size 9/16", Length 10'

(6) Were any formations sealed against pollution?  
X yes, \_\_\_\_\_ no.

If YES depth of formation \_\_\_\_\_

Why Health Dept Reports

Drillers Remarks: \_\_\_\_\_

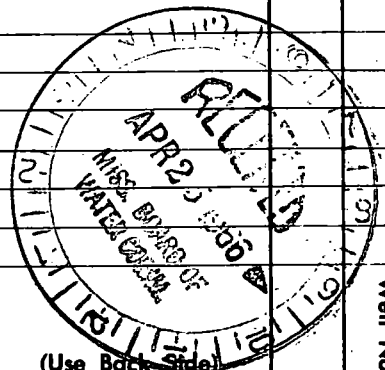

Well No.

(Use Back Side)

