

HARRISON
M 2105
7-26-75

MISSISSIPPI
 BOARD OF WATER COMMISSIONERS
 416 North State Street
 Jackson, Mississippi 39201

138

WATER WELL DRILLERS LOG

COASTAL DRILLING & SERVICE CO. *Harrison*

7/26/75
 date well completed

ROUTE # BOX 618

county well located

LANDOWNER: *J.W. Massena*
RT 2 Box 273W
Belair, Miss
 (mailing address)

WELL LOCATION:
 sec. 18 T. 7 N. R. 9 E
 S W
Dyersville
 (distance) (direction) of (nearest town)

WELL PURPOSE: *Home*
 (home, irrigation, municipal, industrial)

- WELL COMPLETION DATA:
- (1) diameter (inches) 2"
 - (2) total depth (feet) 725
 - (3) static water level (feet) 45 below above top of ground.
 - (4) casing PVC, 710
 (material) (depth)
 (size) If telescope see back.
 - (5) screen 15', 710
 (length) (depth to top)
2", PVC
 (size) (material)
 - (6) pump 1/2, 15
 (HP) (yield gpm)
Electric
 (type power)
 - (7) electric log No
 (yes or no)
- (organization running log)

Description of formations encountered	from to	
Top Soil	1	2
Red Clay	2	10
White Sand	10	45
Soft Blue Clay	45	78
White Sand	78	100
Soft Blue Clay	100	310
hard Blue Clay	310	425
Rock	425	428
hard Blue Clay	428	660
fine water sand	660	660
Coarse water sand	660	725


(8) how well bottom plugged
2" fresh water table

DRILLERS REMARKS:
None

RECORDED
 INDEXED
 MAR 17 1976

If well telescopes please sketch and show depths.

GROUND LEVEL

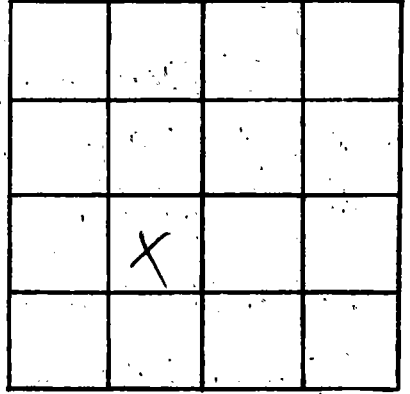

SECTION _____

Please indicate well location X.

ADDITIONAL INFORMATION

If more than one screen, show locations of each on sketch.