

HARRISON
M 2106
8-4-75

MISSISSIPPI
BOARD OF WATER COMMISSIONERS
416 North State Street
Jackson, Mississippi 39201

WATER WELL DRILLERS LOG

COASTAL DRILLING & SERVICE CO. *Harrison*

8/4 1975
date well completed

ROUTE 1 name BOX 618

county well located

LANDOWNER

BILOXI

MISS. 39532
description of formations encountered

from

to

Church of God
Pop-Jenny Rd
Biloxi, Miss
(mailing address)

<i>Top Soil</i>	1	3
<i>Red clay</i>	3	7
<i>Sand gravel</i>	7	65
<i>white sand</i>	65	100
<i>Soft Blue clay</i>	100	340
<i>fine white sand</i>	340	360
<i>Dark Blue clay</i>	360	460
<i>Rock</i>	460	462
<i>hard Blue clay</i>	462	500
<i>fine white sand</i>	500	520
<i>Dark water sand</i>	520	568

WELL LOCATION:

sec. 18 T 7 N R 9 E
S W
Pop-Jenny Rd
(distance) (direction) (nearest town)

WELL PURPOSE:

(home, irrigation, municipal, industrial)
Church

WELL COMPLETION DATA:

- (1) diameter (inches) 2"
- (2) total depth (feet) 568'
- (3) static water level (feet) 100' below above top of ground.
- (4) casing PVC, 558'
(material) (depth)
- (size) if telescope see back.
- (5) screen 10', 558'
(length) (depth to top)
- (size) (material)
2" PVC
- (6) pump One 12
(HP) (yield gpm)
- (type power)
Ele
- (7) electric log No
(yes or no)

(organization running log)

(8) how well bottom plugged


2" back wash tube

DRILLERS REMARKS:

MAR 17 1976

If well telescopes please sketch and show depths.

GROUND LEVEL

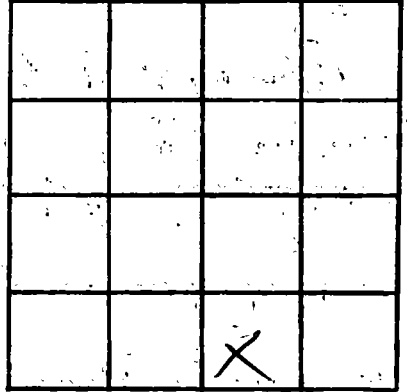

SECTION _____

Please indicate well location X.

ADDITIONAL INFORMATION

If more than one screen, show locations of each on sketch.