

Harrison
M 2107
9-30-75

MISSISSIPPI
 BOARD OF WATER COMMISSIONERS
 416 North State Street
 Jackson, Mississippi 39201

WATER WELL DRILLERS LOG

30 SEPT 1975 RAYNT Well CO HARRISON
 date well completed firm name county well located

LANDOWNER: Floyd Gill
913 Calvert St.
Biloxi, Ms.
 (mailing address)

WELL LOCATION:
 sec. 3 T. 7 S. R. 12 W.
4 miles NW of Biloxi
 (distance) (direction) (nearest town)

WELL PURPOSE: HOME
 (home, irrigation, municipal, industrial)

WELL COMPLETION DATA:

(1) diameter (inches) 2

(2) total depth (feet) 457

(3) static water level (feet) 59 below above top of ground.

(4) casing PVC 447
 (material) (depth)

- If telescope see back.
 (size)

(5) screen 10' 447
 (length) (depth to top)

909 PVC
 (size) (material)

(6) pump 1 10
 (HP) (yield gpm)


Electric
 (type power)

(7) electric log NO
 (yes or no)

(organization running log)

(8) how well bottom plugged Metal
Sand Shank

description of formations encountered	from	to
Red clay	0	11
White sand	11	17
Red clay	17	77
Sand	77	79
Blue clay	79	111
Fine sand	111	119
Blue clay	119	357
Fine sand	357	363
Blue clay	363	394
Good sand	394	457

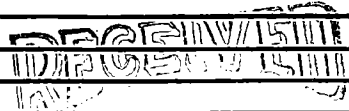

DEC 17 1975

MISS. Bd. OF WATER COMMISSIONERS

DRILLERS REMARKS:

If well telescopes please sketch and show depths.

GROUND LEVEL

		X	

SECTION 3

Please indicate well location X.

ADDITIONAL INFORMATION

If more than one screen, show locations of each on sketch.