

Harrison  
 M 2108  
 10-7-75

MISSISSIPPI  
 BOARD OF WATER COMMISSIONERS  
 416 North State Street  
 Jackson, Mississippi 39201

WATER WELL DRILLERS LOG

10-7-75 date well completed  
 McNeil Well Works firm name  
 Harrison county well located

LANDOWNER: Fred Collins  
 2815 - Pass Road  
 Gulfport (mailing address)  
 WELL LOCATION:  
 sec 22 T 7 N R 90 E 135  
 2.2 miles S.W. of Cedar Lake  
 (distance) (direction) (nearest town)

WELL PURPOSE: none  
 (home, irrigation, municipal, industrial)

WELL COMPLETION DATA:  
 (1) diameter (inches) 2"  
 (2) total depth (feet) 378'  
 (3) static water level (feet) 28' below top of ground.  
 (4) casing plastic, 368' (material) (depth)  
 (size) If telescope see back.  
 (5) screen 10' (length) (depth to top)  
 2" (size) 3.5 (material)  
 (6) pump 1 (HP) 12 (yield gpm)  
 yield electric (type power)  
 (7) electric log no (yes or no)  
 (organization running log)  
 (8) how well bottom plugged sand shell


description of formations encountered	from	to
clay	0	20
sand	20	61
slush	61	112
sand	112	187
slush	187	210
sand	210	260
slush	260	315
sand	315	342
slush	342	354
course sand	354	378

DRILLERS REMARKS:

DECEMBER 1975  
 NOV 9 1975  
 MISSISSIPPI BOARD OF WATER COMMISSIONERS

If well telescopes please sketch and show depths.

GROUND LEVEL

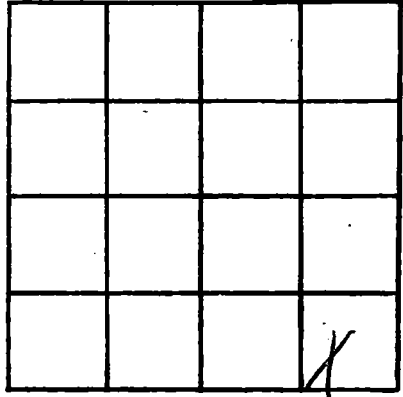

SECTION 12

Please indicate well location X.

ADDITIONAL INFORMATION

If more than one screen, show locations of each on sketch.