

Harrison  
M 2109  
10-14-75

MISSISSIPPI  
 BOARD OF WATER COMMISSIONERS  
 416 North State Street  
 Jackson, Mississippi 39201  
 WATER WELL DRILLERS LOG

14 Dec 1975 RAYNT WELL CO HARRISON  
 date well completed firm name county well located

LANDOWNER: <u>MIKE VALENTINE</u> <u>AT 9 Box 452</u> <u>Gulfport, Ms.</u> (mailing address)	description of formations encountered	from	to
<u>CREEL CIRCLE</u>	<u>Red clay</u>	<u>0</u>	<u>6</u>
	<u>WHITE SAND</u>	<u>6</u>	<u>21</u>
	<u>WHITE CLAY</u>	<u>21</u>	<u>29</u>
	<u>FINE SAND</u>	<u>29</u>	<u>39</u>
	<u>BLUE CLAY</u>	<u>39</u>	<u>151</u>
	<u>FINE SAND</u>	<u>151</u>	<u>164</u>
	<u>BLUE CLAY</u>	<u>164</u>	<u>260</u>
	<u>GOOD SAND</u>	<u>260</u>	<u>291</u>

WELL LOCATION:  
 sec. 19 T. 7 S. R. 10 W.  
1 miles NE of Gulfport  
 (distance) (direction) (nearest town)

WELL PURPOSE: HOME  
 (home, irrigation, municipal, industrial)

- WELL COMPLETION DATA:
- diameter (inches) 2
  - total depth (feet) 291
  - static water level (feet) 15 below above top of ground.
  - casing PVC, 296,  
 (material) (depth)  
— if telescope see back.  
 (size)
  - screen 5', 296  
 (length) (depth to top)  
009, PVC  
 (size) (material)
  - pump 1/2, 8  
 (HP) (yield gpm)  
Electra  
 (type power)
  - electric log NO  
 (yes or no)

(organization running log)

(8) how well bottom plugged Metal  
SAND SHANK

DRILLERS REMARKS:


DRILLING

DEC 17 1975

DOMIN

If well telescopes please sketch and show depths.

GROUND LEVEL

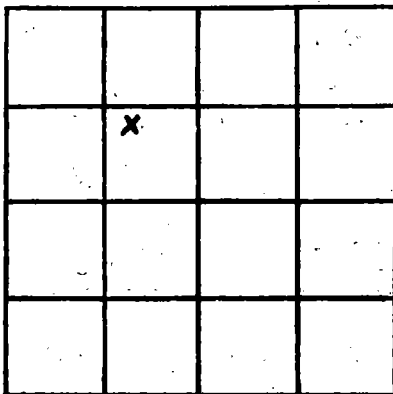

SECTION 19

Please indicate well location X.

ADDITIONAL INFORMATION

If more than one screen, show locations of each on sketch.