

Harrison
M 210
10-25-75

MISSISSIPPI
 BOARD OF WATER COMMISSIONERS
 416 North State Street
 Jackson, Mississippi 39201

WATER WELL DRILLERS LOG

~~10-25-75~~ 25 Oct 1975 BRYANT WELL CO HARRISON
 date well completed firm name county well located

LANDOWNER: ALBERT KING
RT 1 Box 343
Biloxi, Ms
 (mailing address)

description of formations encountered	from	to
<u>RED CLAY</u>	<u>0</u>	<u>15</u>
<u>WHITE SAND</u>	<u>15</u>	<u>38</u>
<u>BLUE CLAY</u>	<u>38</u>	<u>49</u>
<u>GOOD SAND</u>	<u>49</u>	<u>129</u>

WELL LOCATION:
 sec. 9 T. 7 S. R. 9 W.
2 miles N of Biloxi
 (distance) (direction) (nearest town)

WELL PURPOSE: HOME
 (home, irrigation, municipal, industrial)

WELL COMPLETION DATA:

(1) diameter (inches) 2

(2) total depth (feet) 129

(3) static water level (feet) 17 below
 top of ground.

(4) casing PVC, 123
 (material) (depth)
 (size) If telescope see back.

(5) screen 5', 123
 (length) (depth to top)
200, PVC
 (size) (material)

(6) pump 1/2 8
 (HP) (yield gpm)
Electric
 (type power)

(7) electric log NO
 (yes or no)

(organization running log)


(8) how well bottom plugged Metal
SAND SPARK

DRILLERS REMARKS:

[Faint, illegible text from the reverse side of the page is visible through the paper.]

If well telescopes please sketch and show depths.

GROUND LEVEL

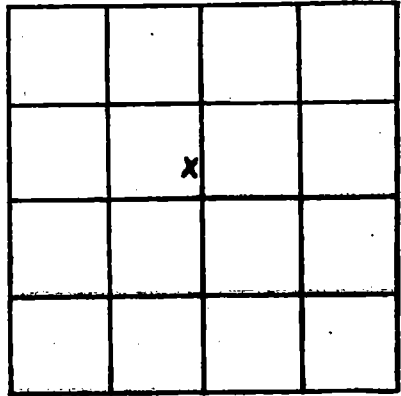

SECTION 9

Please indicate well location X.

ADDITIONAL INFORMATION

If more than one screen, show locations of each on sketch.