

HARRISON
M 2112
11-5-75

MISSISSIPPI
BOARD OF WATER COMMISSIONERS
416 North State Street
135 Jackson, Mississippi 39201

WATER WELL DRILLERS LOG
COASTAL DRILLING & SERVICE CO.

11/5 1975 date well completed ROUTE 1 name BOX 618 Harrison county well located

LAND OWNER: Jack Publishing Co.
RT 5 Box 602
Tidwell, Miss.
(mailing address)

description of formations encountered	from	to
top soil	1	3
white sand	3	35
fine sand	35	70
soft blue clay	70	200
hard blue clay	200	265
fine water sand	265	380


WELL LOCATION:
sec. 9 T 7 N R 9 E
S W
Dillenville
(distance) (direction) (nearest town)

WELL PURPOSE: home
(home, irrigation, municipal, industrial)

- WELL COMPLETION DATA:
- (1) diameter (inches) 2"
 - (2) total depth (feet) 280'
 - (3) static water level (feet) 20 below above top of ground.
 - (4) casing PVC, 280' (material) (depth)
(size) If telescope see back.
 - (5) screen 10', 270' (length) (depth to top)
2" PVC (size) (material)
 - (6) pump one 15 (HP) (yield gpm)
Elec (type power)
 - (7) electric log no (yes or no)
- (organization running log)

(8) how well bottom plugged
I had to wash object

DRILLERS REMARKS:
none

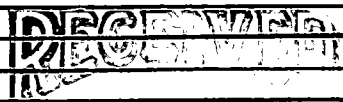

MAR 17 1976

If well telescopes please sketch and show depths.

GROUND LEVEL

	X		

SECTION _____

Please indicate well location X.

ADDITIONAL INFORMATION

If more than one screen, show locations of each on sketch.