

HARRISON  
M 2114  
12/12/75

MISSISSIPPI  
 BOARD OF WATER COMMISSIONERS  
 416 North State Street  
 Jackson, Mississippi 39201

WATER WELL DRILLERS LOG

12/11 date well completed 25 Coastal Drilling Harrison county well located  
Rt 1 Box 8

LANDOWNER: John Hayden

description of formations encountered

from to

Rt 2 Box 604  
Bilal, Miss  
 (mailing address)

<u>Top Soil</u>	<u>1</u>	<u>3</u>
<u>Rd. Clay</u>	<u>5</u>	<u>30</u>
<u>white sand</u>	<u>30</u>	<u>60</u>
<u>Soft blue Clay</u>	<u>60</u>	<u>180</u>
<u>fine water sand</u>	<u>180</u>	<u>200</u>
<u>Coarse water sand</u>	<u>200</u>	<u>240</u>

WELL LOCATION:

sec. 3 T. 7 N. R. 10 E.  
2 1/2 miles W of Bilal  
 (distance) (direction) (nearest town)

WELL PURPOSE: home  
 (home, irrigation, municipal, industrial)

WELL COMPLETION DATA:


- (1) diameter (inches) 2"
- (2) total depth (feet) 240'
- (3) static water level (feet) 90 <sup>below</sup> above top of ground.
- (4) casing PVC, 230'  
 (material) (depth)
- (size) If telescope see back.
- (5) screen 10', 230'  
 (length) (depth to top)
- 2", PVC  
 (size) (material)
- (6) pump 1 1/2, 6  
 (HP) (yield gpm)
- Ele  
 (type power)
- (7) electric log No  
 (yes or no)

(organization running log)

(8) how well bottom plugged  
2" hole with valve

DRILLERS REMARKS:


none

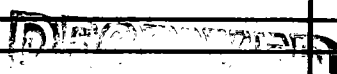

MAR 17 1976

If well telescopes please sketch and show depths.

GROUND LEVEL

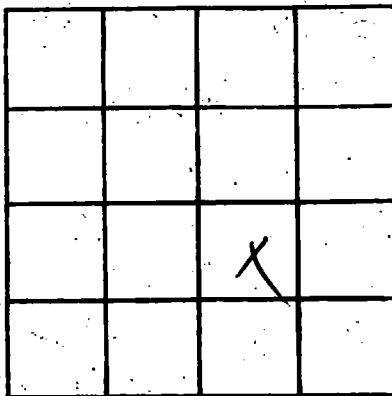

SECTION \_\_\_\_\_

Please indicate well location X.

ADDITIONAL INFORMATION

Lined area for additional information.

If more than one screen, show locations of each on sketch.