

HARRISON
M 215
1-3-76

MISSISSIPPI
 BOARD OF WATER COMMISSIONERS
 416 North State Street
 Jackson, Mississippi 39201

WATER WELL DRILLERS LOG
 COASTAL DRILLING & SERVICE CO.

Harrison
 county well located

1-3-76 19
 date well completed

ROUTE 1 BOX 618

LANDOWNER Chickie Siding
St 2 Bel
Biloxi, Miss
 (mailing address)

WELL LOCATION:
 sec. 18 T. 2 N. R. 9 E.
S W
O'Heavilly
 (distance) (direction) (nearest town)

description of formations encountered	from	to
top soil	1	3
Red Clay	3	15
white sand	15	45
glauw	45	47
Sugar Sand	47	70
Coarse white sand	70	100
Soft Blue Clay	100	310
fine water sand	310	380
hard blue clay	380	560
fine water sand	560	575
Rock	575	577
hard blue clay	577	640
fine water sand	640	660
Coarse white sand	660	725

WELL PURPOSE: none
 (home, irrigation, municipal, industrial)

WELL COMPLETION DATA:

(1) diameter (inches) 2"

(2) total depth (feet) 725'

(3) static water level (feet) 40 below above top of ground.

(4) casing pvc, 715'
 (material) (depth)

(size) If telescope see back.

(5) screen 10', 715'
 (length) (depth to top)

2", pvc
 (size) (material)

(6) pump one, 15
 (HP) (yield gpm)

Elc
 (type power)

(7) electric log no
 (yes or no)

(organization running log)


(8) how well bottom plugged
2' backwash valve

DRILLERS REMARKS:
none

MAR 17 1976

If well telescopes please sketch and show depths.

GROUND LEVEL

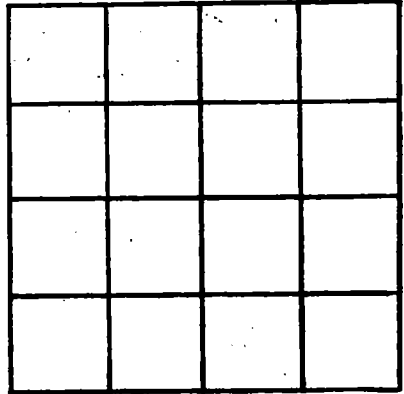

SECTION _____

Please indicate well location X.

ADDITIONAL INFORMATION

If more than one screen, show locations of each on sketch.