

HARRISON
M 2117
1-10-76

MISSISSIPPI
 BOARD OF WATER COMMISSIONERS
 416 North State Street
 Jackson, Mississippi 39201

135

WATER WELL DRILLERS LOG
 COASTAL DRILLING & SERVICE CO.

Harrison
 county well located

1/10 76
 date well completed

ROUTE 1 BOX 618
 Farm Name

BILOXI, MISS. 39532
 City Name

LANDOWNER: Buddy Ford

description of formations encountered	from	to
<u>Top Soil</u>	<u>1</u>	<u>2</u>
<u>Red Clay</u>	<u>2</u>	<u>10</u>
<u>White Sand</u>	<u>10</u>	<u>115</u>
<u>Soft Blue Clay</u>	<u>115</u>	<u>220</u>
<u>Hard Blue Clay</u>	<u>220</u>	<u>280</u>
<u>fine water sand</u>	<u>280</u>	<u>290</u>
<u>Coarse water sand</u>	<u>290</u>	<u>318</u>

RT 5
Bibi's, Davis
 (mailing address)

WELL LOCATION:
 sec. 6 T 7 N R 9 E
S W
Cedar Lake
 (distance) (direction) (nearest town)

WELL PURPOSE: home
 (home, irrigation, municipal, industrial)

WELL COMPLETION DATA:

- (1) diameter (inches) 2"
- (2) total depth (feet) 318'
- (3) static water level (feet) 27 below top of ground.
- (4) casing PVC, 308'
 (material) (depth)
- If telescope see back.
 (size)
- (5) screen 10', 308'
 (length) (depth to top)
- 2", PVC
 (size) (material)
- (6) pump One, 15
 (HP) (yield gpm)
- Ele
 (type power)
- (7) electric log no
 (yes or no)

 (organization running log)

(8) how well bottom plugged
3' hole washed down


DRILLERS REMARKS: no

PROTECTED
 MAR 17 1976

MISS. BD. OF WATER COMM

If well telescopes please sketch and show depths.

GROUND LEVEL

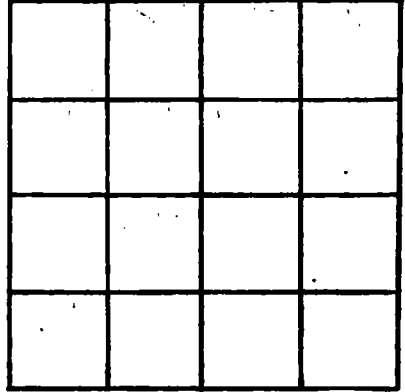

SECTION _____

Please indicate well location X.

ADDITIONAL INFORMATION

Lined area for additional information, consisting of approximately 20 horizontal lines.

If more than one screen, show locations of each on sketch.