

HARRISON
M 2119
4-5-76

MISSISSIPPI
BOARD OF WATER COMMISSIONERS
416 North State Street
Jackson, Mississippi 39201

WATER WELL DRILLERS LOG
COASTAL DRILLING & SERVICE CO.


4/5/76 1976 date well completed ROUTE 1 BOX 618 Harrison county well located

LANDOWNER: McCall, Miss 39532
Ray Rodal
Biloxi, Miss (mailing address)
WELL LOCATION:
sec. 9 T 2 N R 2 E S W
(4) miles N of Oceanville (distance) (direction) (nearest town)
WELL PURPOSE: home (home, irrigation, municipal, industrial)
WELL COMPLETION DATA:

description of formations encountered		from	to
Top Soil		1	3
Red Clay		3	45
White Sand		45	75
Soft Blue Clay		75	120
White Sand		120	145
Soft Blue Clay		145	300
Hard Blue Clay		300	320
Fireclay Sand		320	345
Core Unit Sand			
(1) diameter (inches)	2"		
(2) total depth (feet)	345'		
(3) static water level (feet)	20' below top of ground		
(4) casing (material)	PVC		
(depth)	335'		
(size)	If telescope see back.		
(5) screen (length)	10'		
(depth to top)	335'		
(size)	2"		
(material)	PVC		
(6) pump (HP)	One		
(yield gpm)	14		
(type power)	Ele		
(7) electric log	no		
(yes or no)			
(organization running log)			
(8) how well bottom plugged			
DRILLERS REMARKS:			

If well telescopes please
sketch and show depths.

GROUND LEVEL

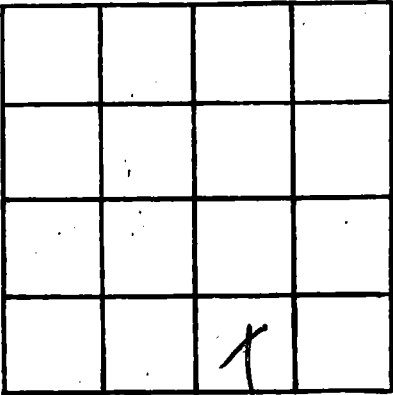

SECTION _____

Please indicate well location X.

ADDITIONAL INFORMATION

If more than one screen,
show locations of each on sketch.