

HARRISON
 M 2122
 5/1/76

MISSISSIPPI
 BOARD OF WATER COMMISSIONERS
 416 North State Street
 135 Jackson, Mississippi 39201

WATER WELL DRILLERS LOG
 COASTAL DRILLING & SERVICE CO.

5/1 1976 ROUTE 1 BOX 618 *Harrison*
 date well completed firm name county well located

BILOXI, MISS 39532

LANDOWNER *Michaly Bellard*
Pop-ferry Rd
Biloxi, Miss
 (mailing address)

WELL LOCATION:
 sec. 18 T 7 N R 9 E
 S W
2 1/2 miles *N* of *Biloxi*
 (distance) (direction) (nearest town)


WELL PURPOSE: *home*
 (home, irrigation, municipal, industrial)

- WELL COMPLETION DATA:
- (1) diameter (Inches) 4 1/2"
 - (2) total depth (feet) 525'
 - (3) static water level (feet) 22 below above top of ground.
 - (4) casing PWE, 490'
 (material) (depth)
4 1/2" if telescope see back.
 (size)
 - (5) screen 15', 490'
 (length) (depth to top)
2" POC
 (size) (material)
 - (6) pump 2 1/2 hp 35
 (HP) (yield gpm)
Ede
 (type power)
 - (7) electric log yes
 (yes or no)
- (organization running log)

description of formations encountered	from to	
	feet	feet
Top Soil	1	3
Soft Blue Clay	3	18
inter. Sand	18	120
Soft Blue Clay	120	185
(Lenses)	185	190
Soft Blue	190	240
hard Blue	240	295
fine water sand	295	320
hard blue clay	320	430
fine water sand	430	460
coarse water sand	460	525

(8) has well bottom plugged no

DRILLERS REMARKS:
none

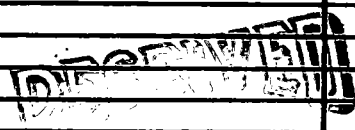

MAY 28 1976

MISS. BD. OF WATER COMM

If well telescopes please sketch and show depths.

GROUND LEVEL

160' 4" PVC Casing




330' 2" PVC Casing



15' 2" PVC Screen

2" back wash valve

If more than one screen, show locations of each on sketch.

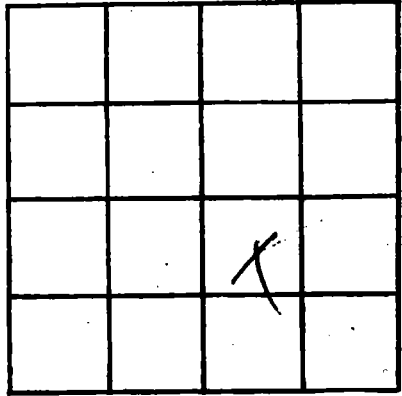

SECTION _____

Please indicate well location X.

ADDITIONAL INFORMATION

Multiple horizontal lines for additional information.