

Harrison
 M 2123
 5-6-76
 May 6
 Aug 20

MISSISSIPPI
 BOARD OF WATER COMMISSIONERS
 416 North State Street
 Jackson, Mississippi 39201

WATER WELL DRILLERS LOG

1976 McGil Well Works Inc. Harrison
 date well completed firm name county well located

LANDOWNER: Joe Sadner
 230 - 24th St.
 Hef. Mo. 39501
 (mailing address)

description of formations encountered	from to	
Course Sand	0	30
Blue mud	30	48
Course Sand	48	50

WELL LOCATION:
 sec. 29 T 7 N ? R 10 E
 4 1/2 miles (S) NW 1/4 of Biltmore
 (distance) (direction) (nearest town)

WELL PURPOSE: down
 (home, irrigation, municipal, industrial)


- WELL COMPLETION DATA:
- (1) diameter (inches) 2"
 - (2) total depth (feet) 30'
 - (3) static water level (feet) 3' below top of ground
 - (4) casing photo 10' (depth)
 2" (size) If telescope see back.
 - (5) screen 10' (length) (depth to top)
 2" (size) plastic (material)
 - (6) pump 1/2 (HP) 1 (yield gpm)
 Electric (type power)
 - (7) electric log (yes or no)
 - (organization running log)
 - (8) how well bottom plugged Capped

DRILLERS REMARKS:

RECEIVED
 AUG 16 1976

If well telescopes please sketch and show depths.

GROUND LEVEL

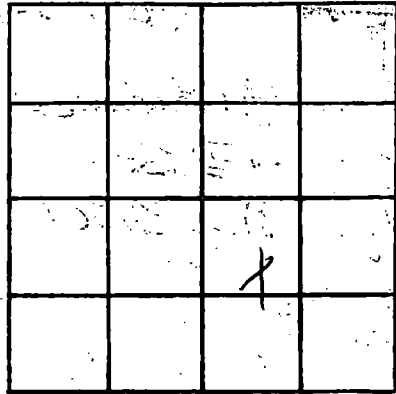

SECTION 29

Please indicate well location X.

ADDITIONAL INFORMATION

If more than one screen, show locations of each on sketch.