

HARRISON
M 2124
5/13/76

MISSISSIPPI
BOARD OF WATER COMMISSIONERS
 416 North State Street
 Jackson, Mississippi 39201

WATER WELL DRILLERS LOG
COASTAL DRILLING & SERVICE CO.

date well completed 5/13 1976 ROUTE 1 BOX 618 Harrison county well located

LANDOWNER OK J. Jones
Rt 5 Leggett job
Subst. in in
 (mailing address)

WELL LOCATION:
 sec. 6 T. 7 N. R. 10 E.
None miles NW of Louane
 (distance) (direction) (nearest town)


WELL PURPOSE: home
 (home, irrigation, municipal, industrial)

- WELL COMPLETION DATA:
- (1) diameter (inches) 2"
 - (2) total depth (feet) 285'
 - (3) static water level (feet) 18 below above top of ground.
 - (4) casing PVC, 225'
 (material) (depth)
 - (size) If telescope see back.
 - (5) screen 10', 225'
 (length) (depth to top)
 - 2", PVC
 (size) (material)
 - (6) pump One, 15
 (HP) (yield gpm)
 - Ele
 (type power)
 - (7) electric log Yes
 (yes or no)
- (organization running log)

(8) how well bottom plugged 2" lead wash tubes

DRILLERS REMARKS:


description of formations encountered	from	to
top soil	1	3
Red Clay	3	15
glaucon	15	20
white sand	20	45
Soft Blue Clay	45	70
Red Sand	70	85
Soft Blue Clay	85	100
Blue Sand	100	120
Red Blue Clay	120	250
fine white sand	250	260
Recon water sand	260	285

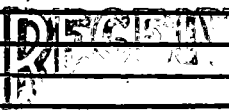

MAY 17 1976

If well telescopes please sketch and show depths.

GROUND LEVEL

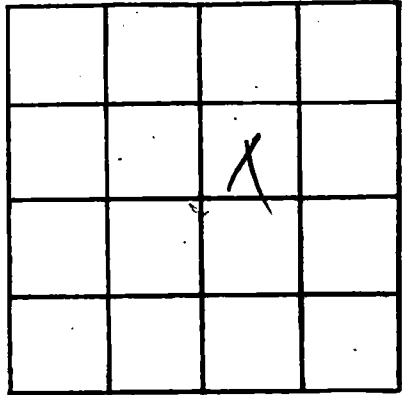

SECTION _____

Please indicate well location X.

ADDITIONAL INFORMATION

If more than one screen,
show locations of each on sketch.