

**HARRISON**  
**M 2129**  
**7-2-76**

**MISSISSIPPI**  
**BOARD OF WATER COMMISSIONERS**  
 416 North State Street  
 Jackson, Mississippi 39201

**WATER WELL DRILLERS LOG**


7-2-76 19 76 MC Bill Well Works Harrison  
 date well completed firm name county well located

LANDOWNER: <u>Hef. Mrs.</u> <u>Ocean View Apts</u> <u>515 - 16<sup>th</sup> St.</u> (mailing address)	description of formations encountered	from	to
	<u>sand</u>	<u>0</u>	<u>30</u>
<b>WELL LOCATION:</b>			
sec. <u>32</u> T. <u>7</u> N. R. <u>0</u> E. <u>4</u> miles <u>E</u> of <u>Hef.</u> (distance) (direction) (nearest town)			
<b>WELL PURPOSE:</b> <u>lawn</u> (home, irrigation, municipal, industrial)			
<b>WELL COMPLETION DATA:</b>			
(1) diameter (inches) <u>2"</u>			
(2) total depth (feet) <u>30'</u>			
(3) static water level (feet) <u>3'</u> <u>below</u> above top of ground.			
(4) casing <u>PVC sch. 40</u> <u>20'</u> (material) (depth)			
_____ if telescope see back. (size)			
(5) screen <u>10'</u> _____ (length) (depth to top)			
<u>2"</u> _____ (size) (material) <u>plastic</u>			
(6) pump <u>1/2</u> <u>14</u> (HP) (yield gpm)			
<u>electric</u> (type power)			
(7) electric log <u>no</u> (yes or no)			
_____ (organization running log)			
(8) how well bottom plugged <u>capped</u>			
<b>DRILLERS REMARKS:</b>			

**RECEIVED**  
 FEB 14 1977

If well telescopes please sketch and show depths.

GROUND LEVEL

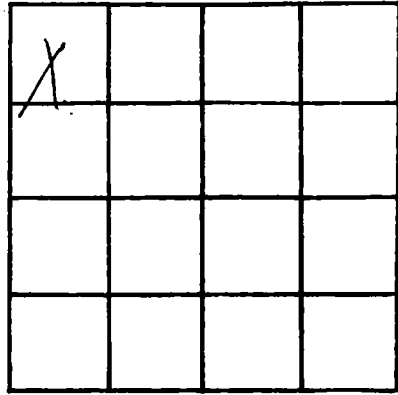

SECTION 32

Please indicate well location X.

ADDITIONAL INFORMATION

If more than one screen,  
show locations of each on sketch.